© SIMON MORRAY-JONES. ALL DIMENSIONS TO BE CHECKED ON SITE BEFORE WORK COMMENCES. ANY DISCREPANCIES TO BE REPORTED TO THE ARCHITECT.

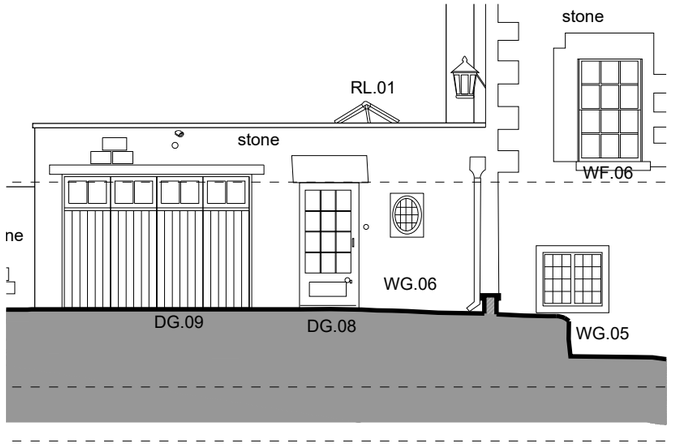

1:100 - Existing garage courtyard elevation.

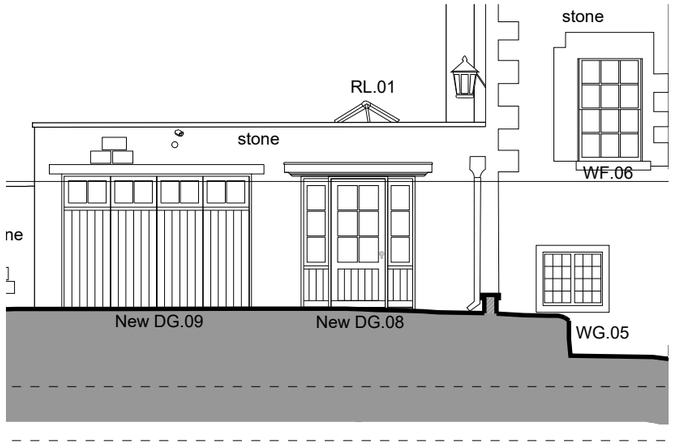

1:100 Currently approved alterations (PL/2023/01539)

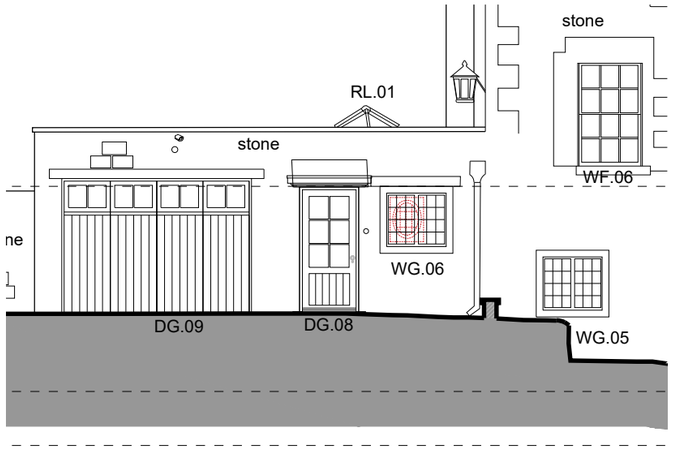

1:100 Alternative garage courtyard door and window options.

0m 2m 4m
Scale: 1:100

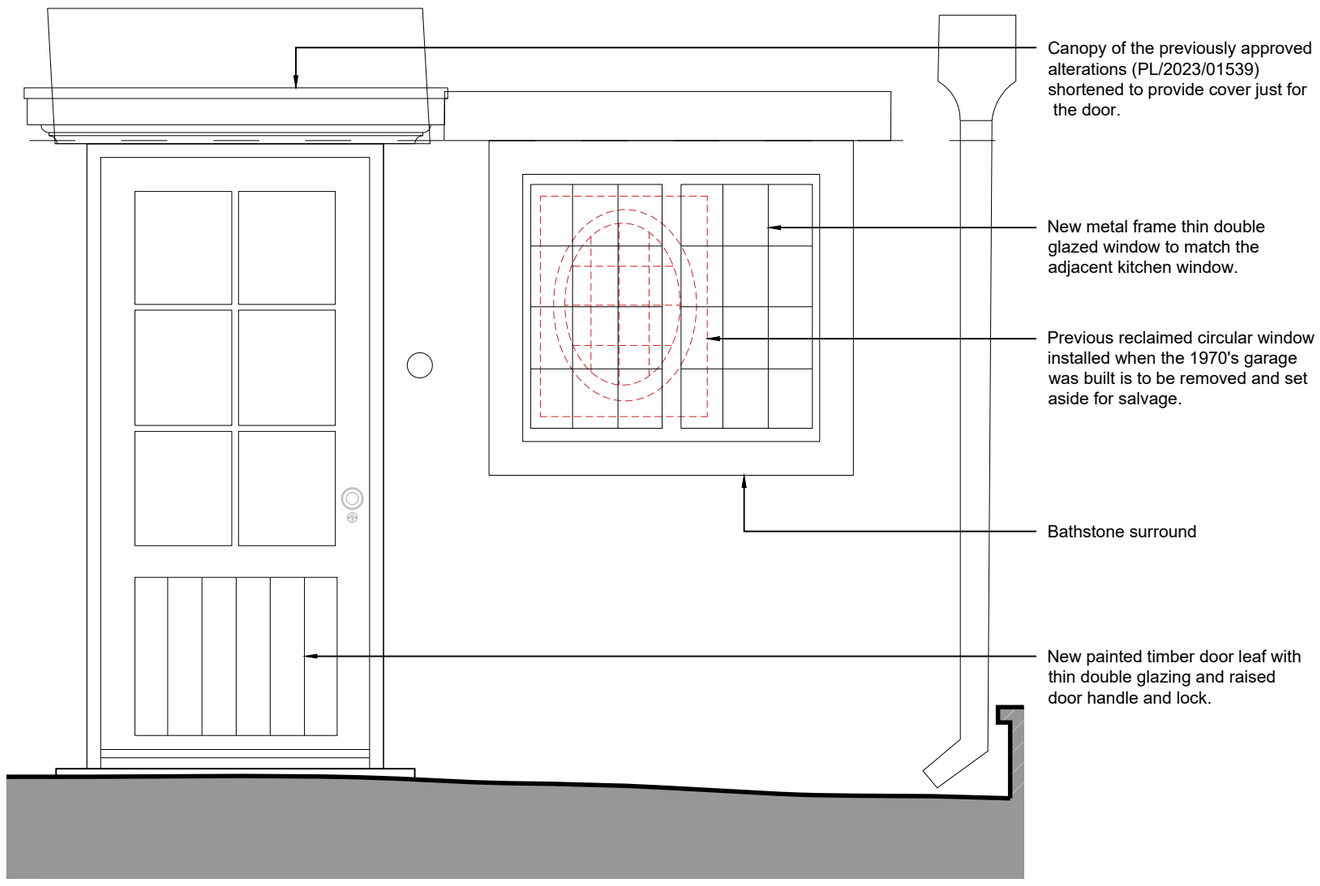

1:20 Proposed Door DG08 and window WG06 elevation.

Existing garage

The proposals include an alternative window and door arrangement for DG08 and WG06, to that already approved within PL/2023/01539. Both DG08 and WG06 were installed when the garage was built in the 1970's and therefore the proposed alterations would not remove any historic fabric or be detrimental to the historic building.

DG08 is a painted timber frame door and the proposals include replacing the leaf only with the design approved within PL/2023/01539, however it is proposed to use thin double glazing.

WG06 was previously approved within PL/2023/01539 to be removed and this proposal includes a new square shaped window to match WG05 in the kitchen with a Bathstone lintel and surround. Thin double glazing is proposed.



PLANNING

Revision	Date

SIMON MORRAY-JONES
CHARTERED ARCHITECTS & DESIGNERS
21 MILSOM STREET, BATH BA1 1DE
TEL: 01225 787900 FAX: 01225 787901
EMAIL: sm-j@sm-j.com

Client
Jason & Sarah Clarkin Yates

Project
St Olaves
Bradford on Avon

Drawing Title
Proposed
Garage courtyard
Window and door alterations

Scale @ A3	Drawn By	Date
Varies at A3	SW	08/23

Job Number	Drawing Number	Revision
1315	PL20	