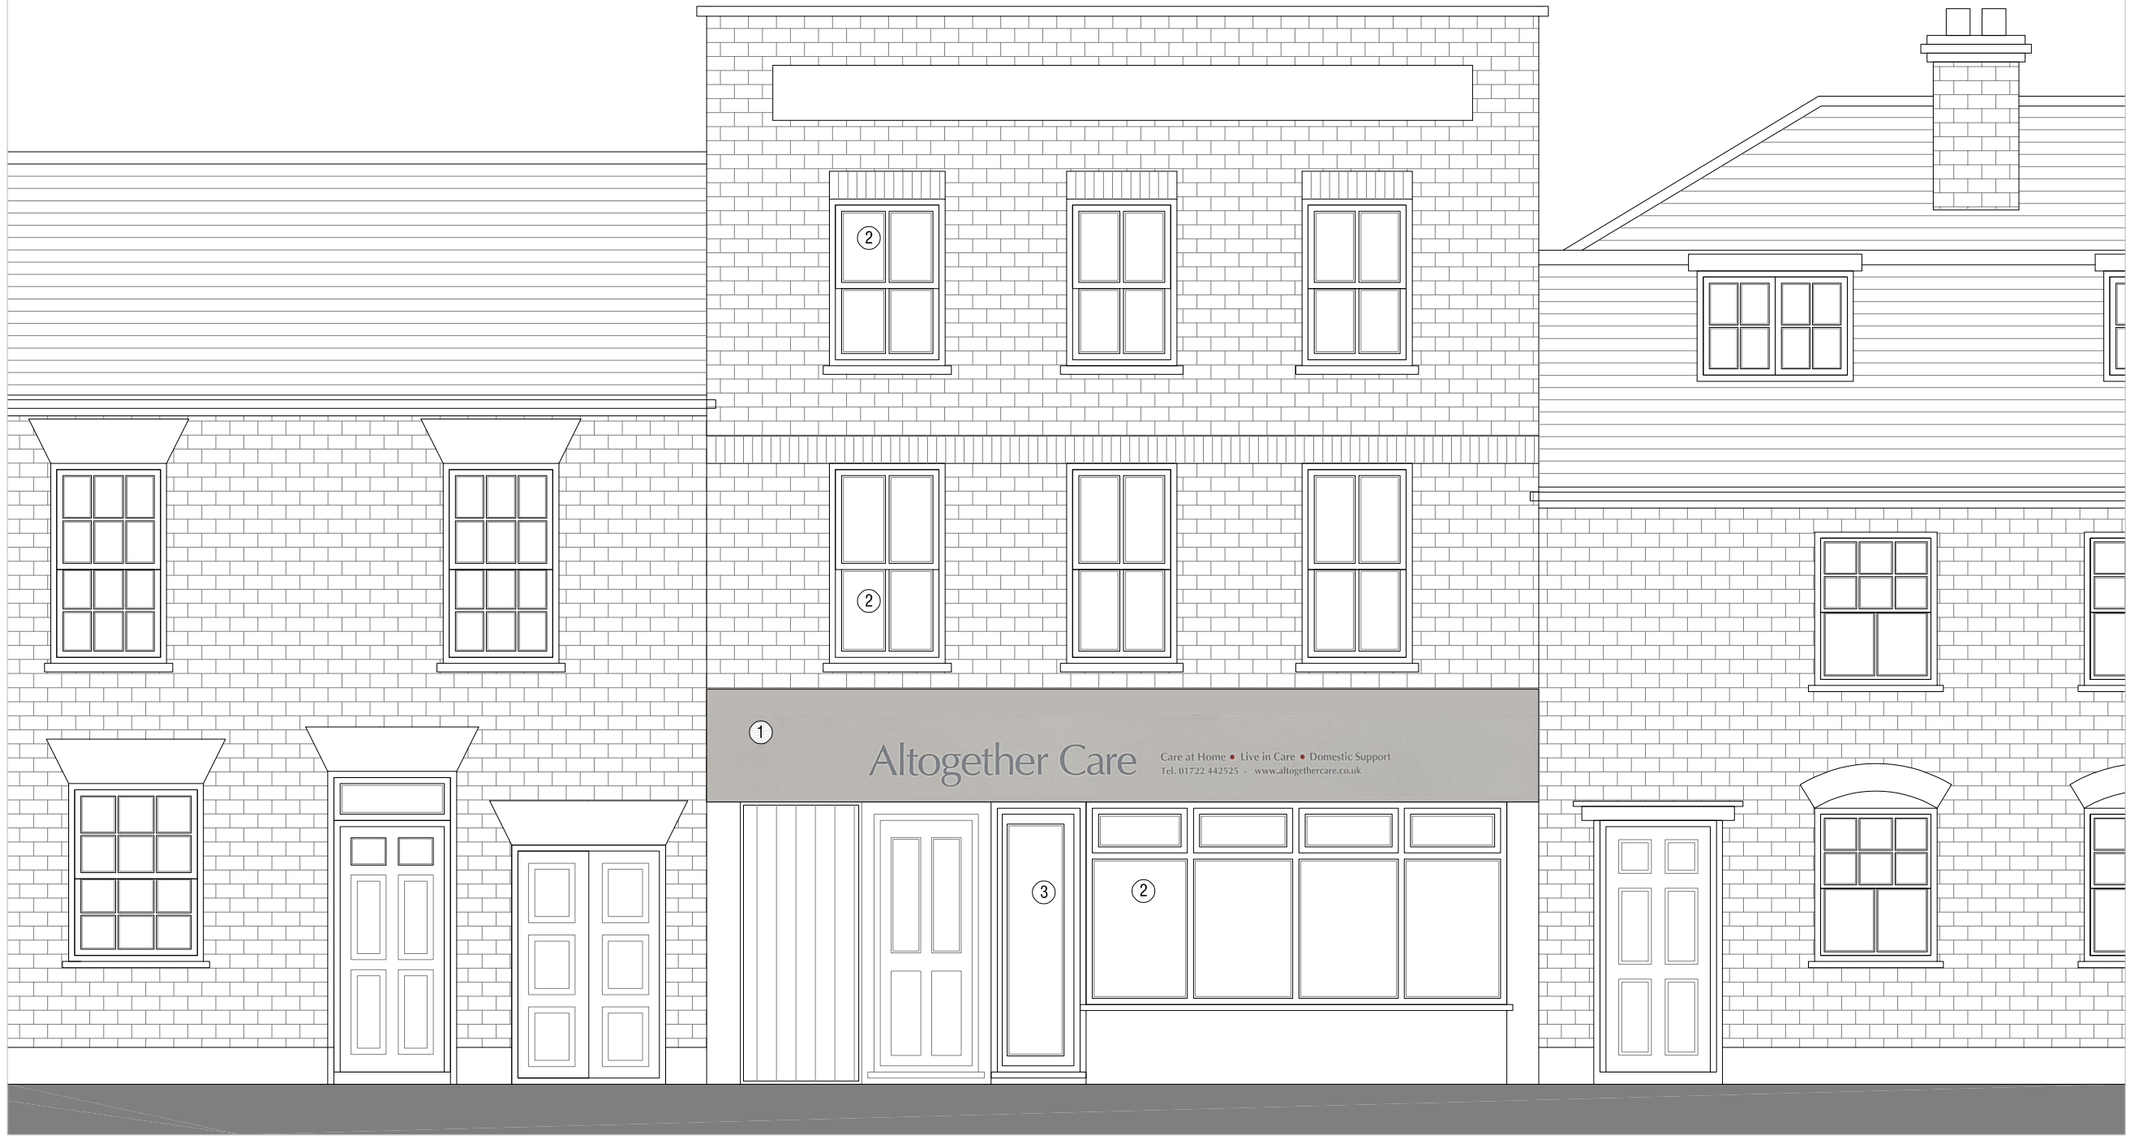

01 - As-Built Front Elevation

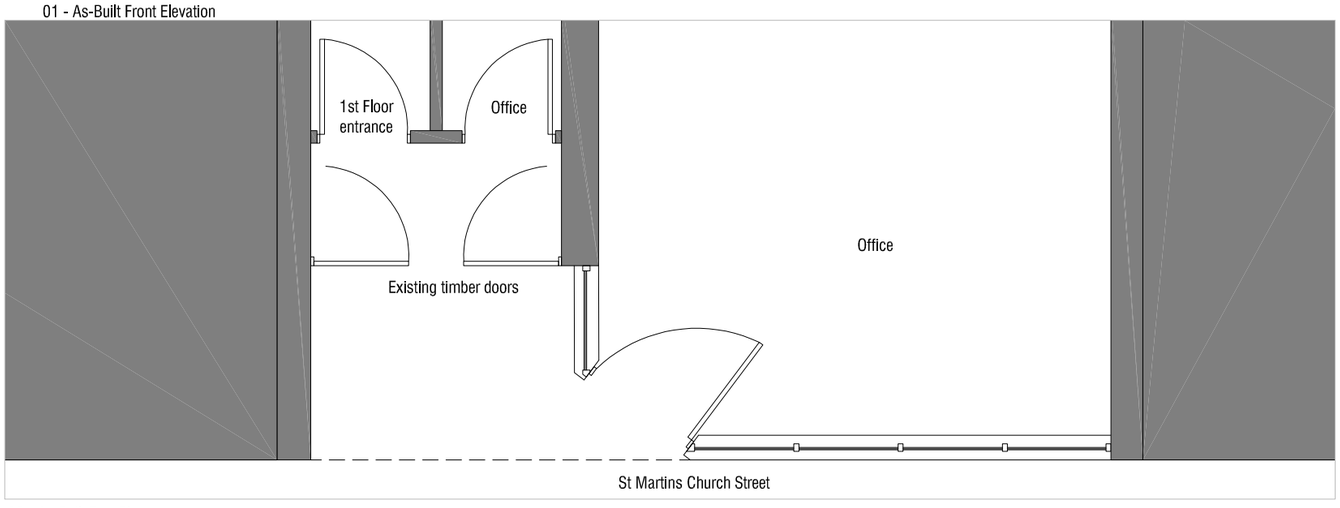

02 - As-Built Part Plan

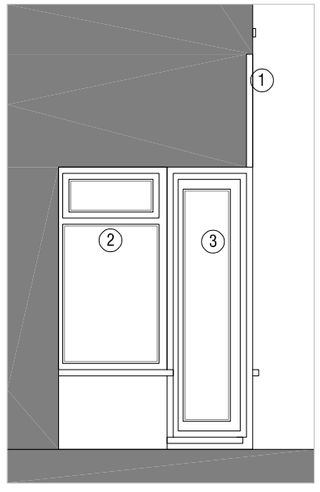

03 - As-Built Internal Elevation

Materials Key:
1 - Painted Render Signage
2 - UPVC Windows
3 - UPVC Door

0 0.5 1 1.5 2 2.5

Rev:	Date:	Revision History:
B	01.09.23	Signage added
A	26.07.23	First Issue

ESDON ARCHITECTURE
T: 01722 680 419
M: 07810 647 790
W: info@esdon-architecture.com

Project:
23-061
62 St Edmunds Church Street

	Name:	Date:		Name:	Date:
Designed by:	EE		Checked:	EE	
Drawn By:	EE		Approved:	EE	

Scale: 1:50 @ A3
Status: Planning

Drawing Title:
As-Built Front Elevation

Drawing No: 10-100
Rev: B