

SOUTH-EAST / FRONT ELEVATION

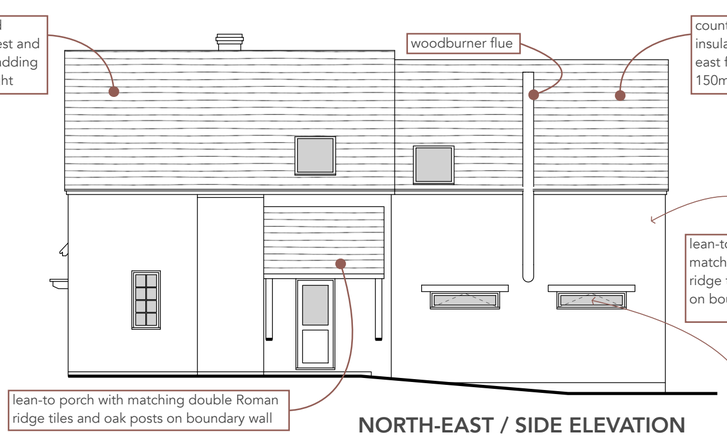

NORTH-EAST / SIDE ELEVATION

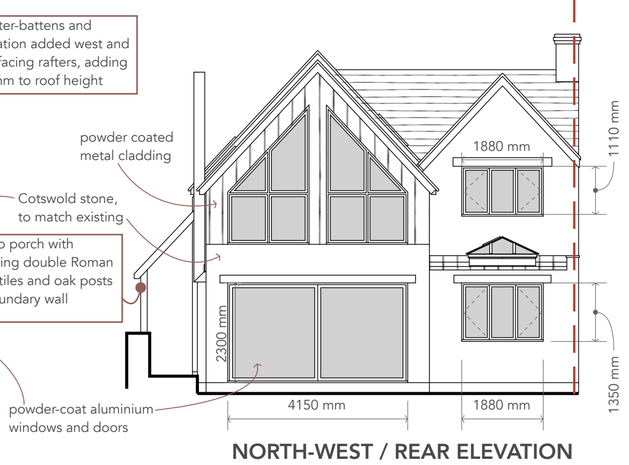

NORTH-WEST / REAR ELEVATION

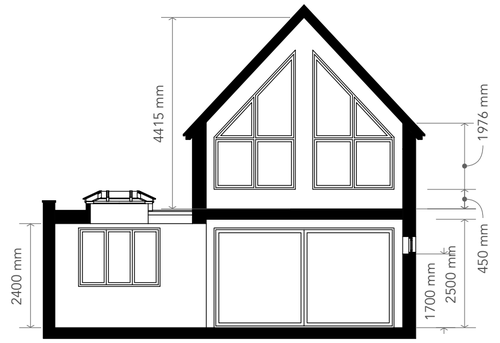

SECTION C - C

GARAGE

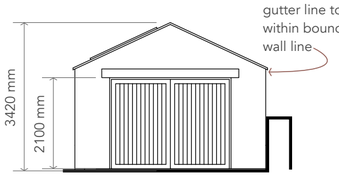

SOUTH-EAST ELEVATION

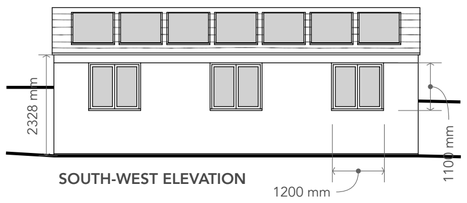

SOUTH-WEST ELEVATION

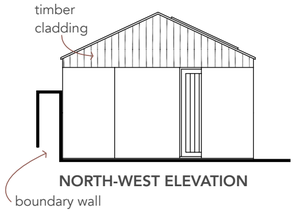

NORTH-WEST ELEVATION

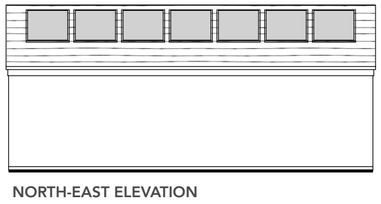

NORTH-EAST ELEVATION

GARAGE PROPOSED MATERIALS:

- Cotswold stone walls
- Imitation slate roof tiles
- Solar PV panels
- Hardwood doors
- Powder-coated aluminium windows

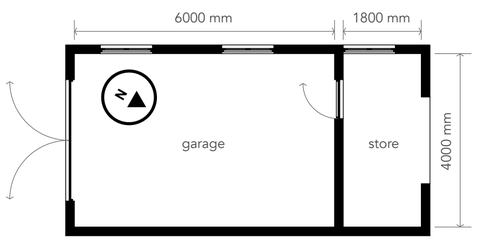

FLOOR PLAN

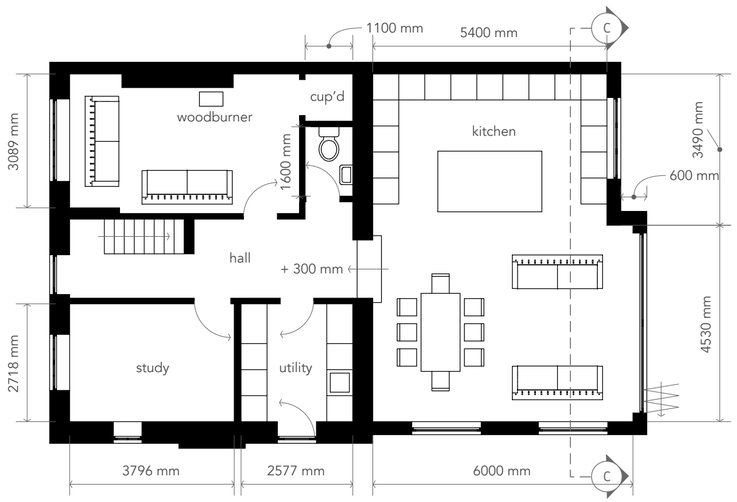

GROUND FLOOR PLAN

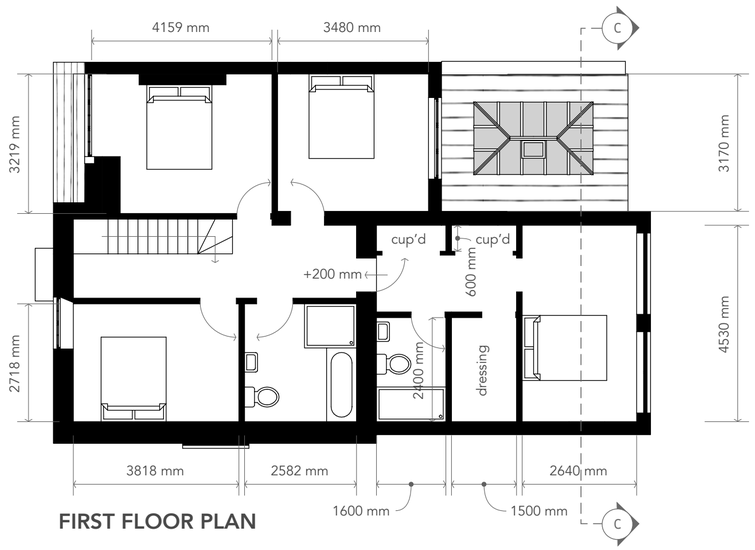

FIRST FLOOR PLAN

ROOF, GARAGE and FRONT GARDEN PLAN

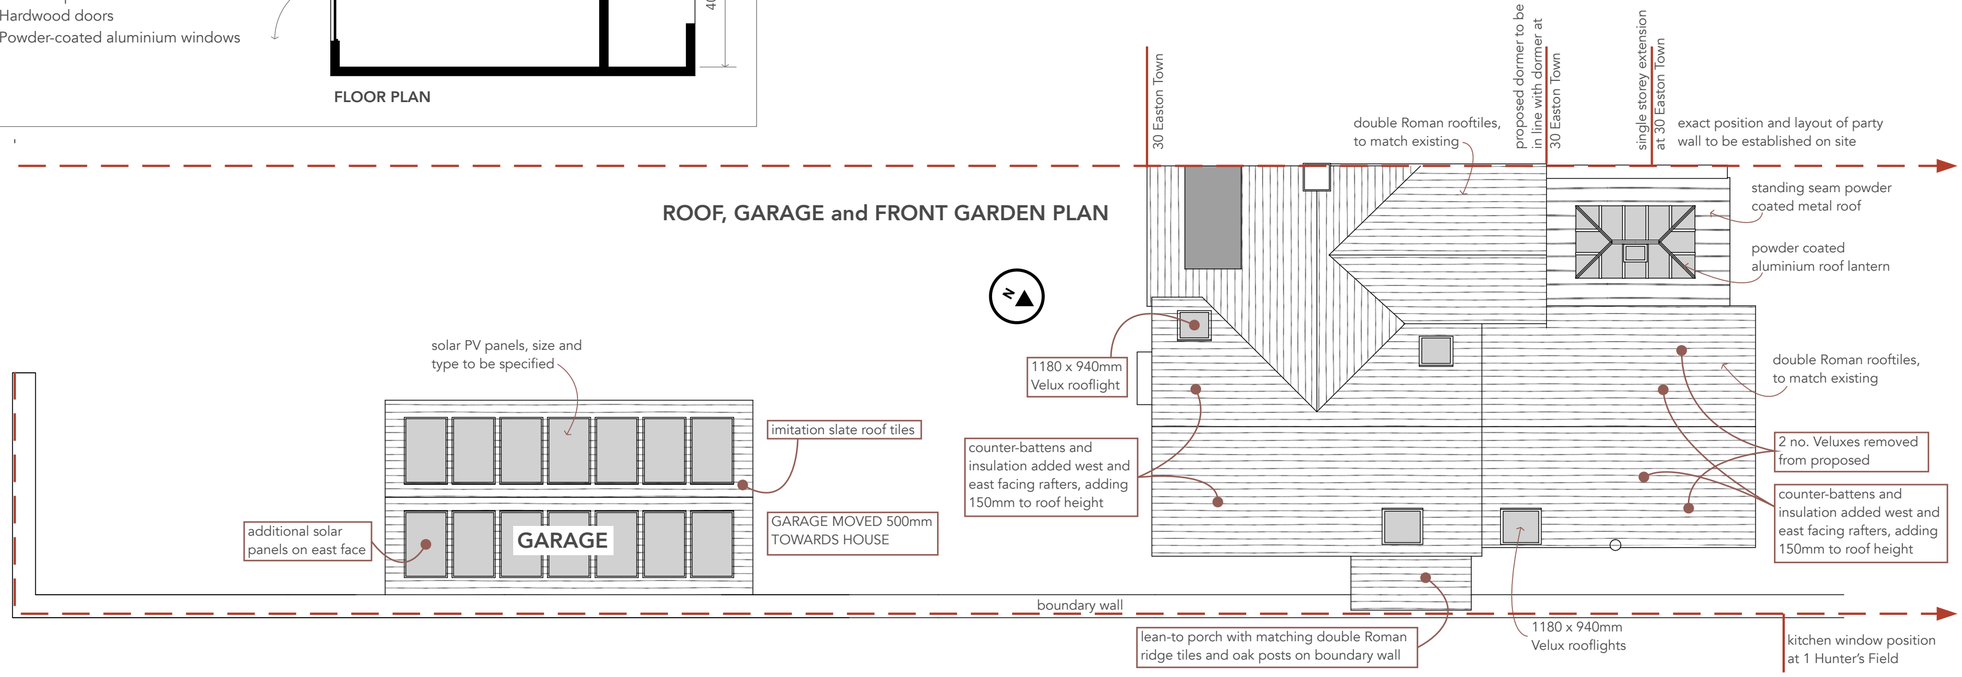

0 scale 1 : 100 10m

REVISION B

REVISIONS SHOWN IN RED BOXES

all dimensions to be confirmed on site
all works to be carried out in accordance with current Building Regulations
drawings and design copyright of SE Architecture and may not be copied, altered or reproduced without authority

project:

32 Easton Town, Sherston. SN16 0LS

drawing:

4 : Proposed Plans and Elevations

1 : 100 on A2

August 2023

SE Architecture
07814 685519
www.se-architecture.co.uk