© THIS DRAWING IS A COPYRIGHT OF BARKER ASSOCIATES.

THIS DRAWING IS TO BE READ IN CONJUNCTION WITH ALL RELEVANT STRUCTURAL ENGINEERS AND MECHANICAL AND ELECTRICAL ENGINEERS DRAWINGS, DETAILS AND SPECIFICATIONS.

KEY

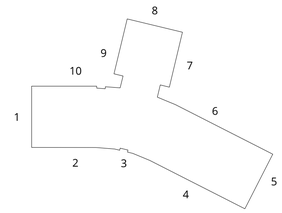

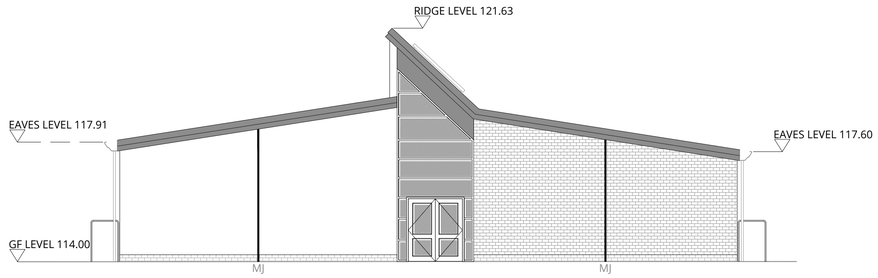

Elevation 1 (Phase 1 - As Constructed)

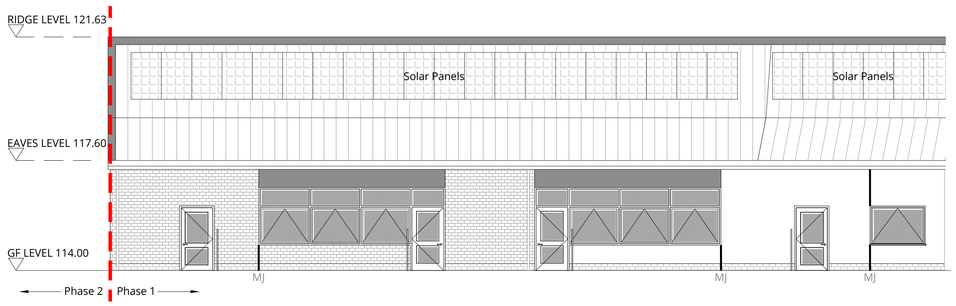

Elevation 2 (Phase 1 - As Constructed)

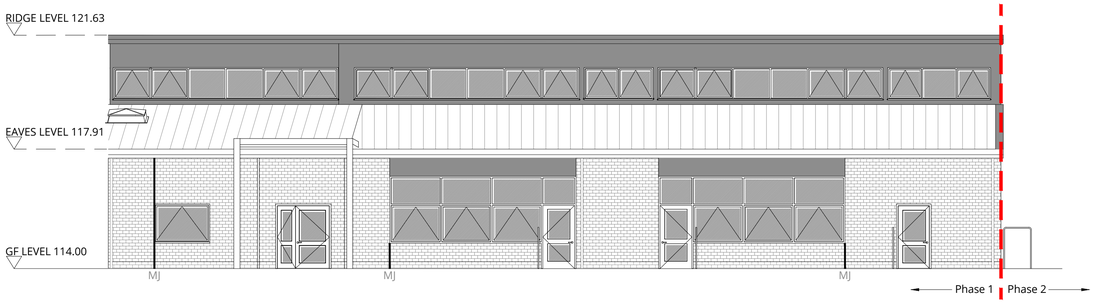

Elevation 10 (Phase 1 - As Constructed)

Scale 1:100
0 1 2 3 4 5 10 (metres)

Drawing Status:
NMA APPLICATION

Rev	Description	Date	By
P01	NMA PLANNING APPLICATION	23/08/23	YK

Barker
MAJESTY HOUSE, AVENUE WEST
SKYLINE 120, BRAINTREE
ESSEX, CM77 7AA
T: 01279 647111
W: www.barker-associates.co.uk
E: mail@barker-associates.co.uk

Client
DIOCESE OF SALISBURY ACADEMY TRUST

Project Title
ST PETERS CE PRIMARY ACADEMY
XANTEN WAY, SALISBURY, SP2 9FL

Drawing Title
EXISTING ELEVATIONS - PHASE 1 - AS CONSTRUCTED

Drawn	Checked	Scale	Date
YK	JM	1:100 @ A1	AUG. 23

ARCHITECTURAL

Drawing Number	Project No.	Status	Revision
DST001-BA-A1-GF-DR-A-2002	P23-0390	S0	P01