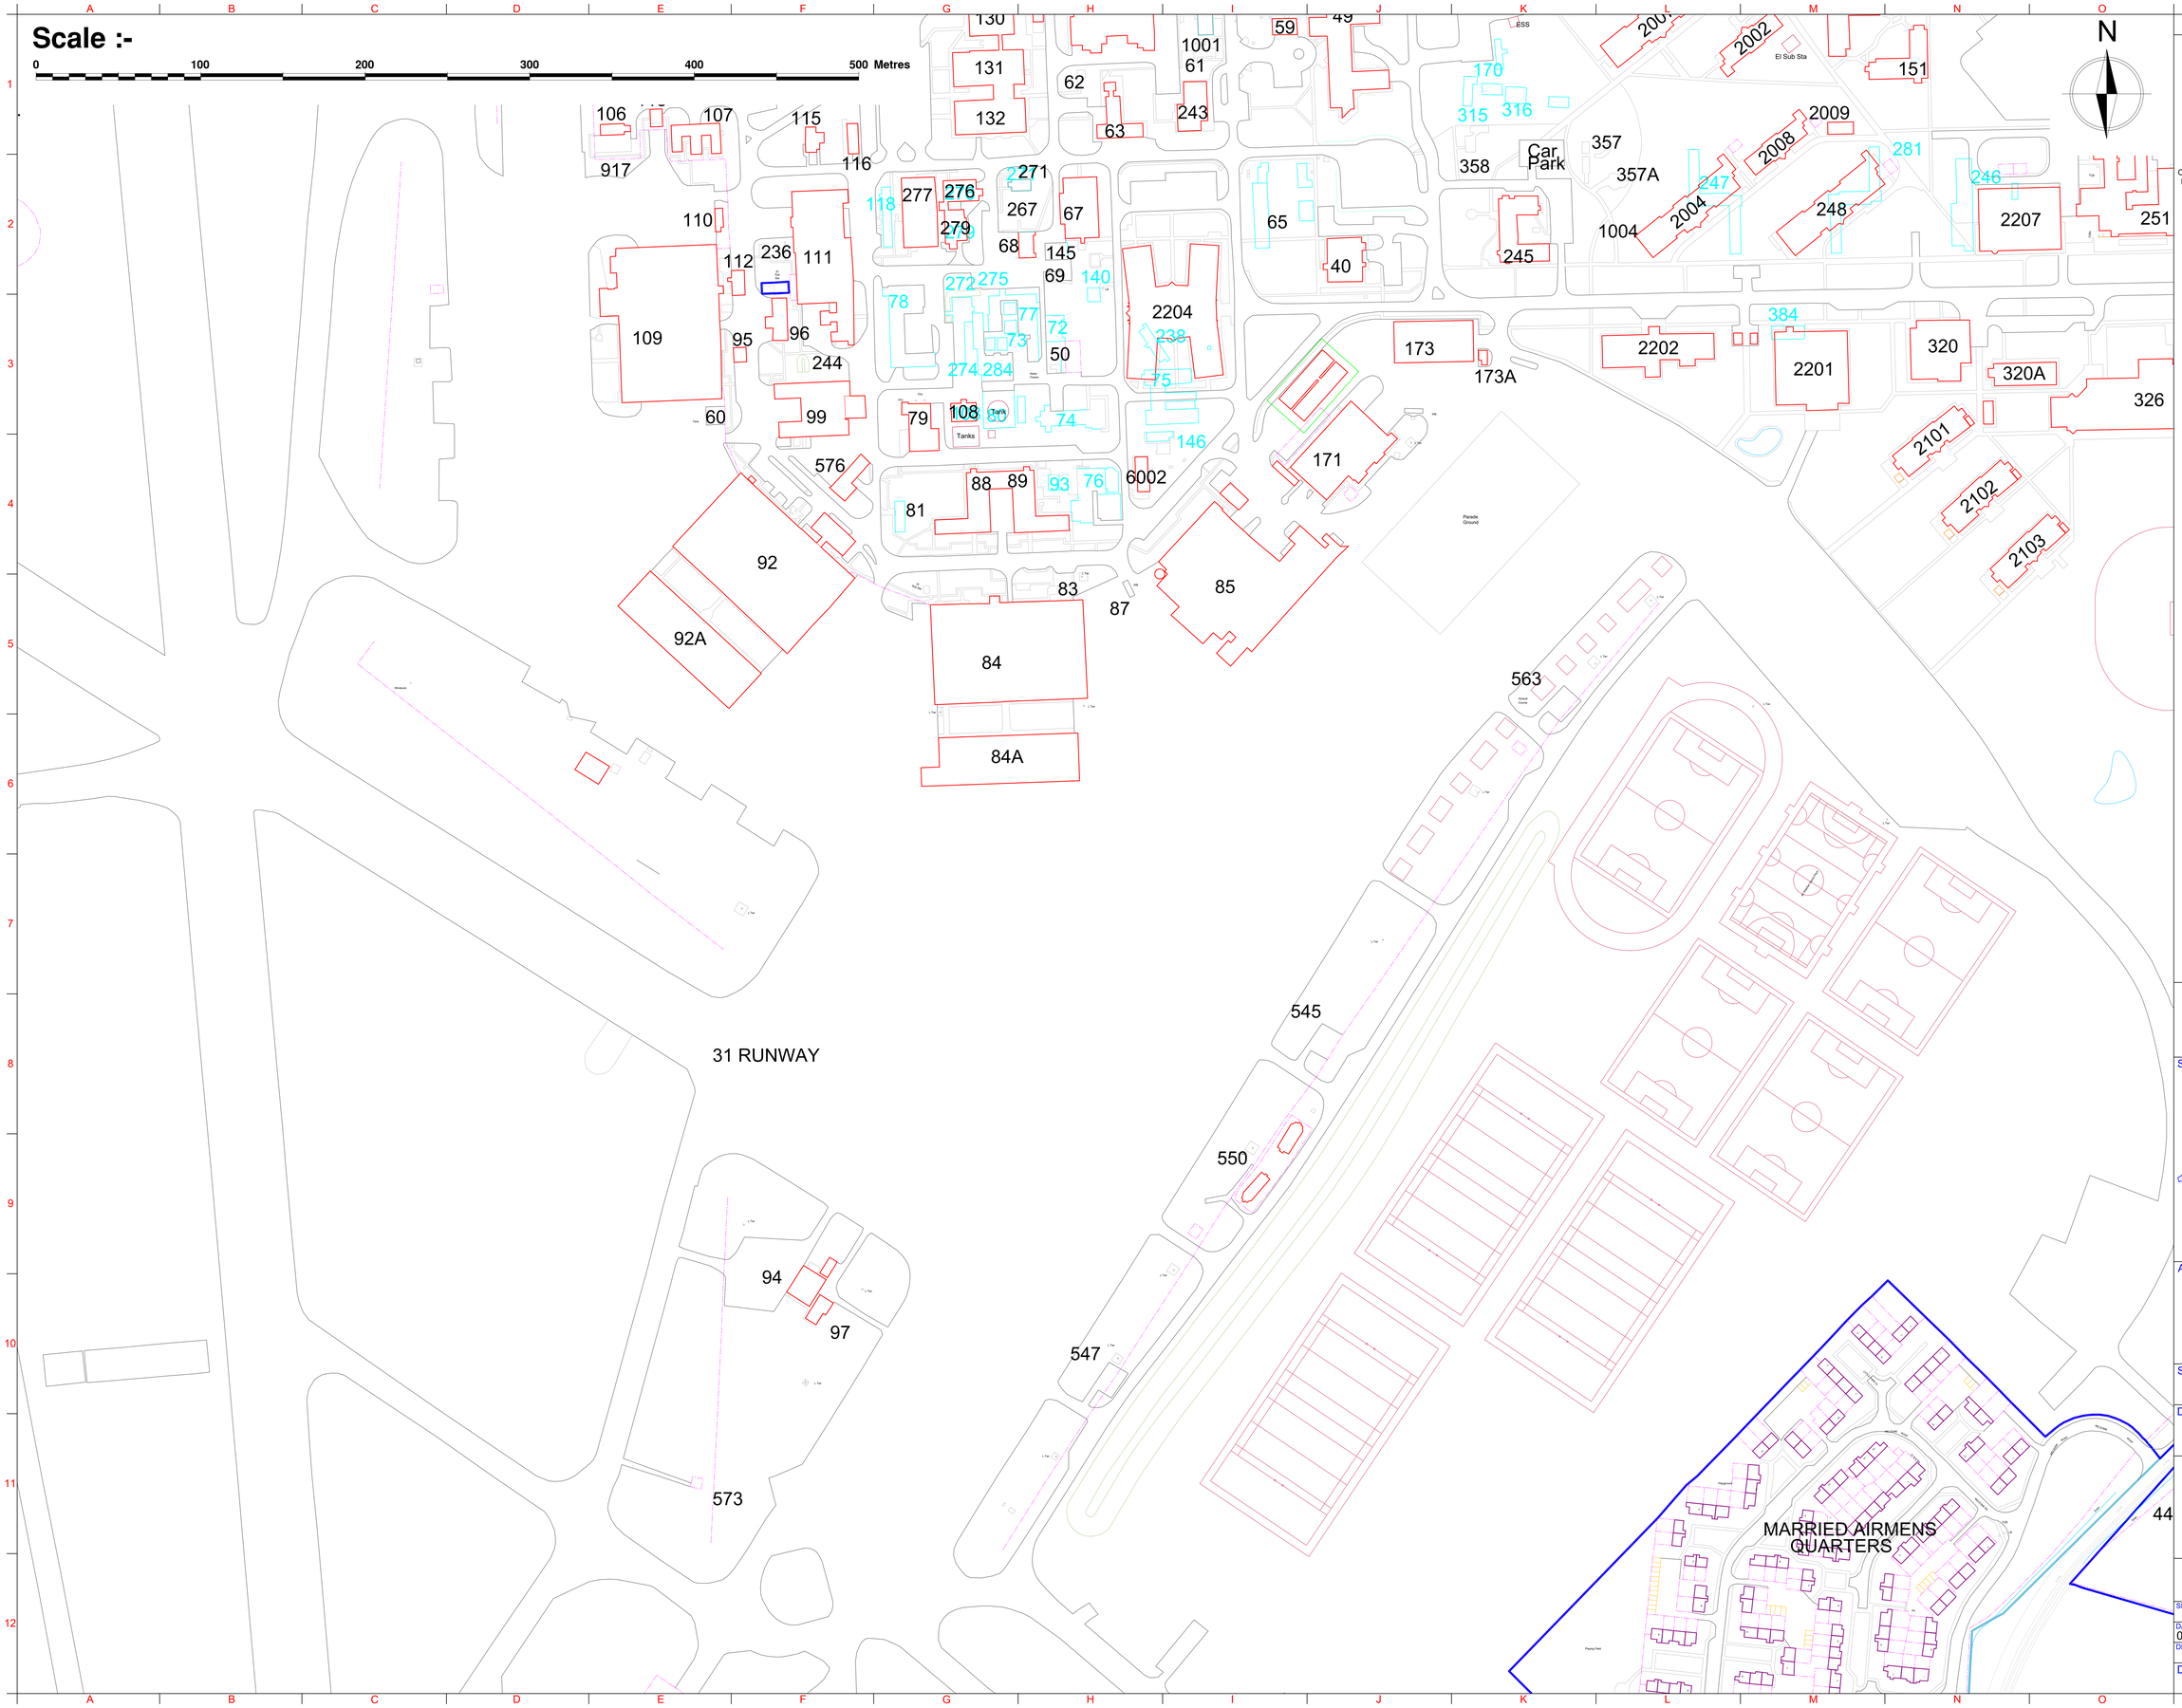

NOTES:

THIS DOCUMENT IS THE PROPERTY OF MINISTRY OF DEFENCE AND MAY NOT BE RETAINED, COPIED, DISTRIBUTED, DISPLAYED OR USED WITHOUT THE EXPRESS PERMISSION OF VIVO DEFENCE.

THIS DRAWING IS FOR INFORMATION ONLY. DO NOT SCALE.

ALL DATA HELD AND ISSUED IS 'AS BUILT'. THE INFORMATION DISPLAYED ON THIS DRAWING IS CONSTANTLY BEING UPDATED AND SUBJECT TO CHANGE. PLEASE CONTACT THE CAD OFFICE FOR THE LATEST VERSION (REFERRING TO 'ISSUED BY' IN THE TITLE BLOCK).
THIS DRAWING MAY HAVE BEEN CREATED USING DATA FROM VARIOUS THIRD PARTY SOURCES, VIVO DEFENCE CAN NOT GUARANTEE THE ACCURACY OF THIS INFORMATION.
IF YOU ARE AWARE OF ANY DRAWINGS (HARD COPY OR OTHERWISE) THAT SUPERSEDE THIS DRAWING, COULD YOU PLEASE LET THE CAD OFFICE KNOW USING THE CONTACT DETAILS ON THE BORDER OF THIS DRAWING.

SITE LOCATION PLAN / MAP:



ASSOCIATED DRAWINGS:

SITE/PROJECT:
RAF LYNEHAM

DWG TITLE:
PART SITE LAYOUT
SHOWING GRIDS J4/O4 TO J8/08

VIVO | Built for Change

CAD DEPARTMENT.
Vivo Defence.
BUILDING 21, HQ SITE, MOD STAFFORD,
BEACONSIDE, STAFFORDSHIRE, ST18 0AQ.
Tel: TBC
Email: cadteam@vivodefence.com

SHEET No 5 OF 8		DETAILS OF ISSUE: 18/08/2023-Beacham, Trevor (VIVO)
DATE DRAWN: 02/11/15	CHECKED BY:	SHEET SIZE: A0
DRAWN BY: EM		SCALE: 1:1250

DWG No:
SW-LYNE-PART-SITE-005