This drawing and its design content is copyright - Jagged Edge Design Ltd.

SCALING

Scaling this drawing as part of the construction process is something we strongly advise against. We appreciate that there are many other non critical reasons for scaling a drawing, if you wish to, at your own risk, first measure the distance between the red lines to the right.

IF THIS DRAWING HAS BEEN ACCURATELY REPRODUCED THE DISTANCE BETWEEN THESE LINES WILL BE EXACTLY 100mm


DRAWING SHEET SIZE

If output to print, this sheet will be able to deliver the drawings to the scale(s) indicated, on an - A1 size media.


WE STRONGLY ADVISE AGAINST USING THE DRAWING SHEET SIZE, IN ANY WAY, FOR DETERMINING SIZES OF PROPOSED BUILDING WORKS. THE TOOLS PROVIDED IN THE FORM OF SCALE BARS AND THE PRINT CHECK ARE FOR THIS PURPOSE.

Elevation Legend


A Imitation stone blockwork
B Concrete Plain Tiles

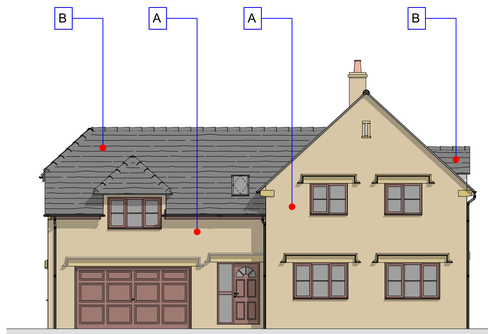


East Elevation - 1:100

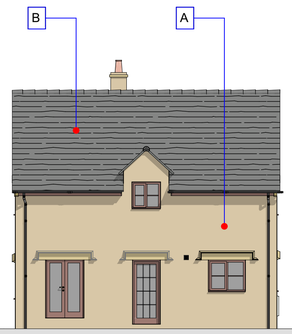


North Elevation - 1:100

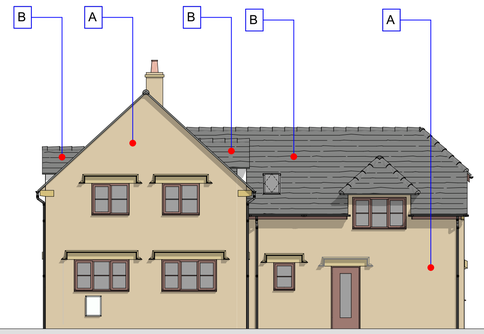


West Elevation - 1:100

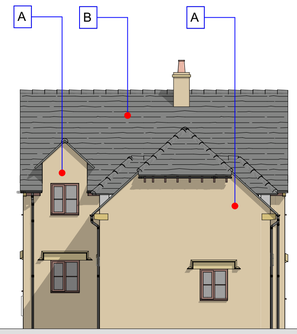

South Elevation - 1:100

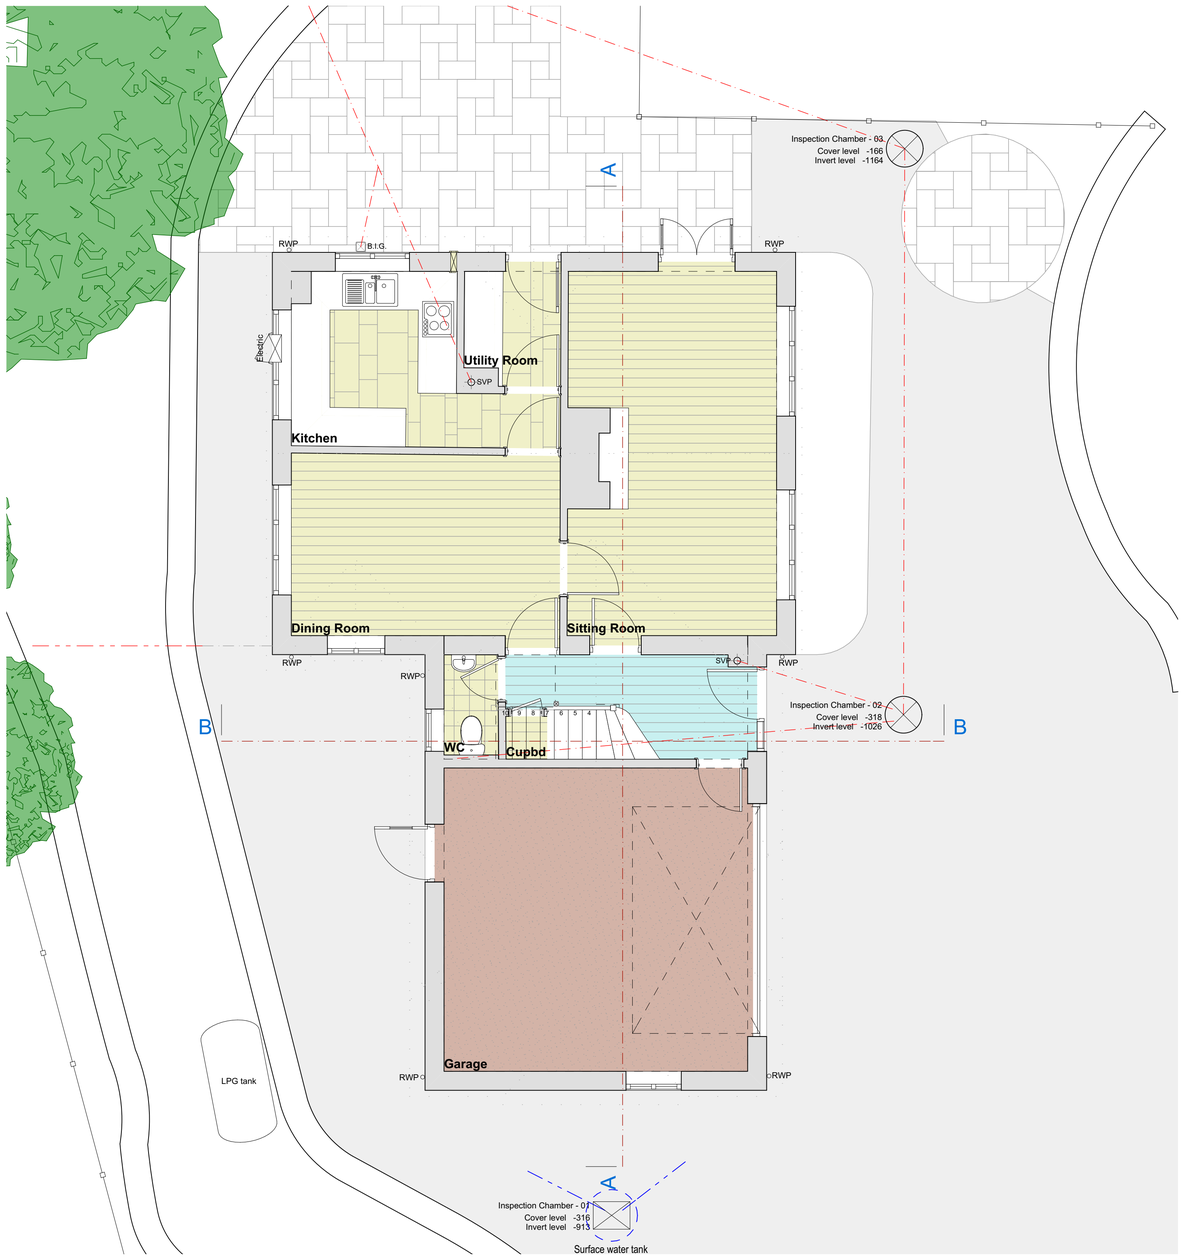

Ground Floor Plan - 1:50

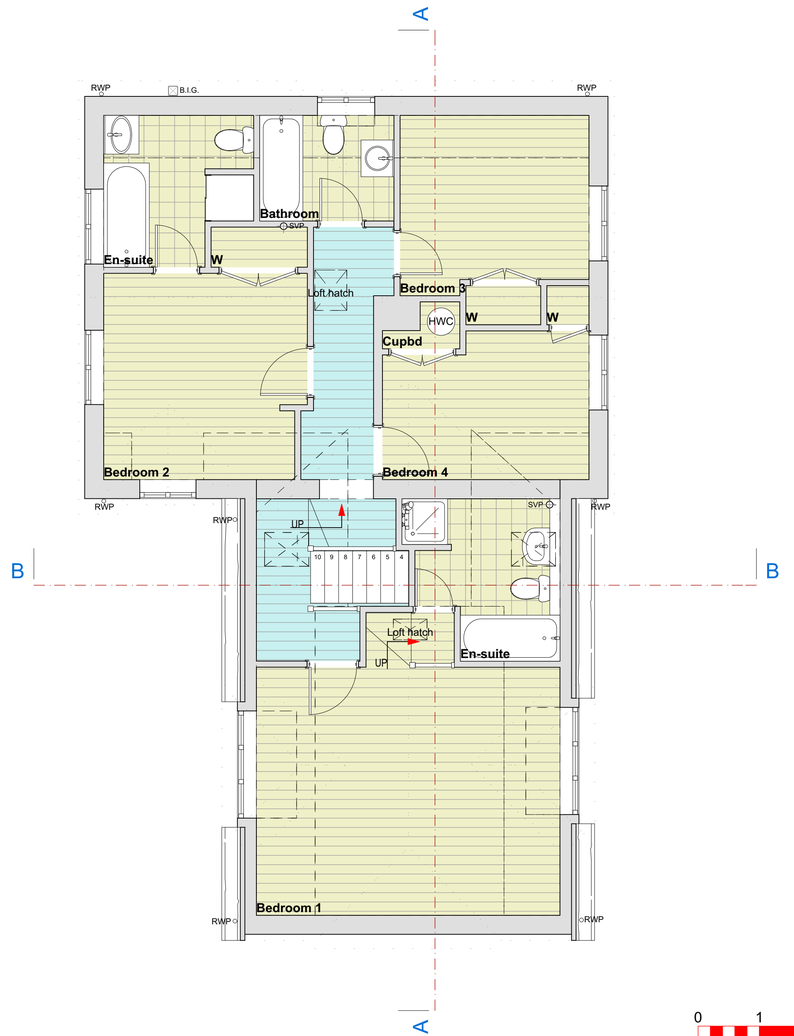

First Floor Plan - 1:50

0 1 2 3 4 5 6
Scale 1: 50

0 2 4 6 8 10 12
Scale 1:100

Project.
Survey Drawings:
Wildar House
The Ridgeway
Crudwell
Malmesbury
SN16 9EQ

Client.
Nadia Mkinsi and Paul Burnett
Wildar House
The Ridgeway
Crudwell
Malmesbury
SN16 9EQ

Title.
Survey Floor Plans and Elevations

Date originated.
Date printed.
28 November 2022

Scale.
1:100, 1:50

Drawn By.
G Lawes

Z:\2022 PROJECTS\2227 - Nadia Mkinsi & Paul Burnett\1000 - CAD Data\1110 - Survey Drawings\2227 - Paul and Nadia - Survey.pln

Drawing No.
2227_001

JaggedEdgeDesignLtd
Architectural Design Specialists
The Studio
Irongate Farm Business Units
Rodmarton
Cirencester
Gloucestershire
GL7 6PD
info@jaggededgedesign.co.uk
www.jaggededgedesign.co.uk