GROUND FLOOR PLAN

SCALE 1:100

0 1 2 3 4 5 M

AREAS MARKED IN RED ARE PROPOSED CHANGES

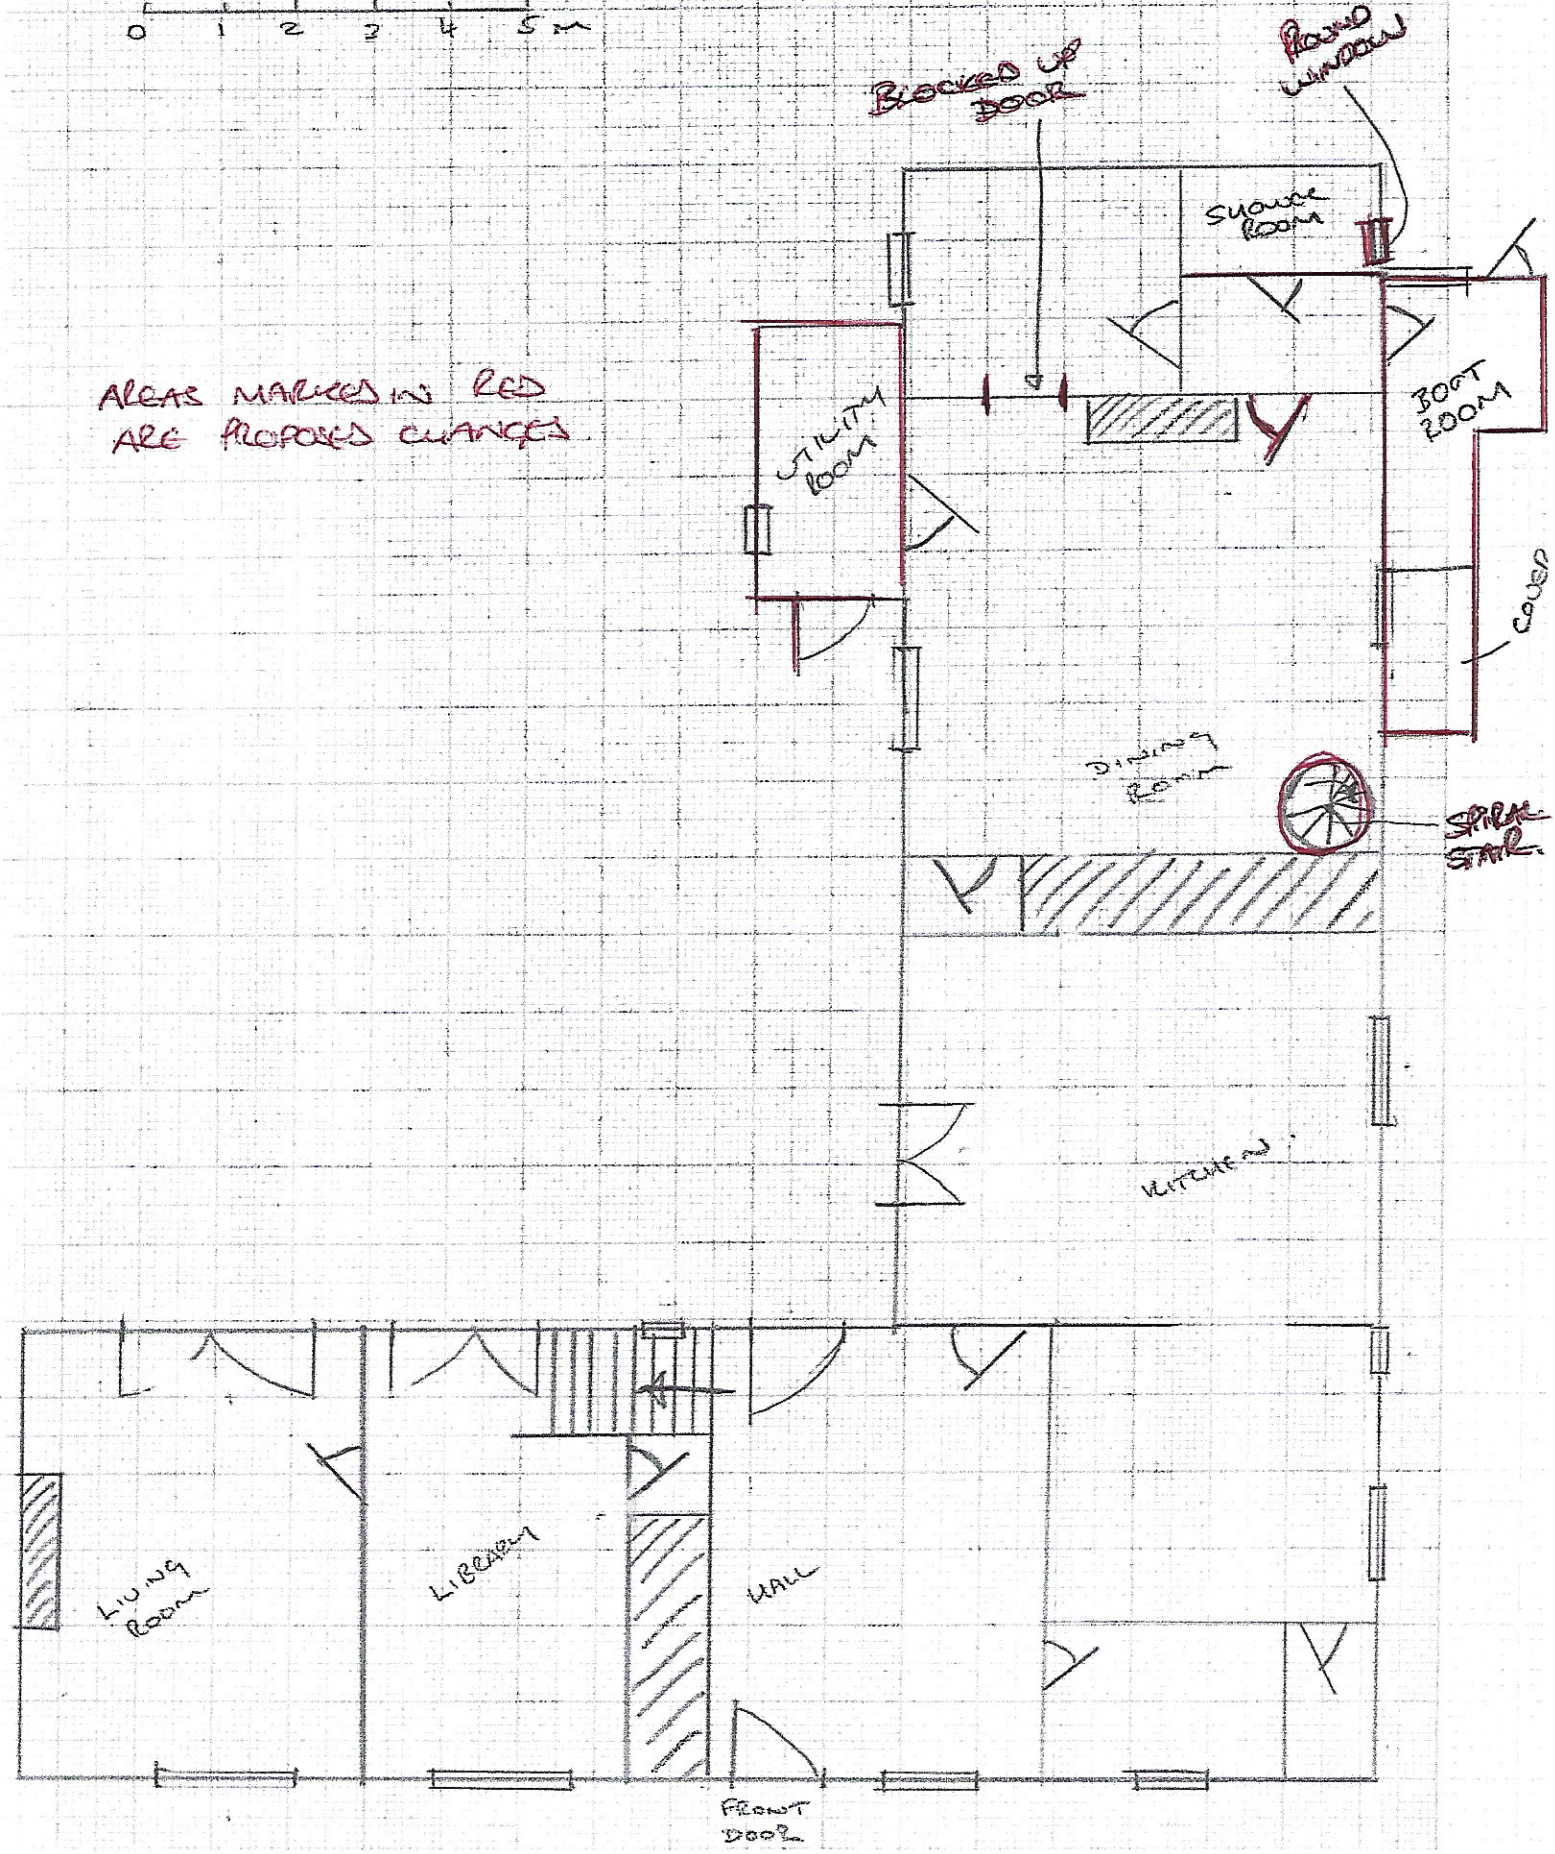

FIRST FLOOR PLAN

SCALE 1:100

