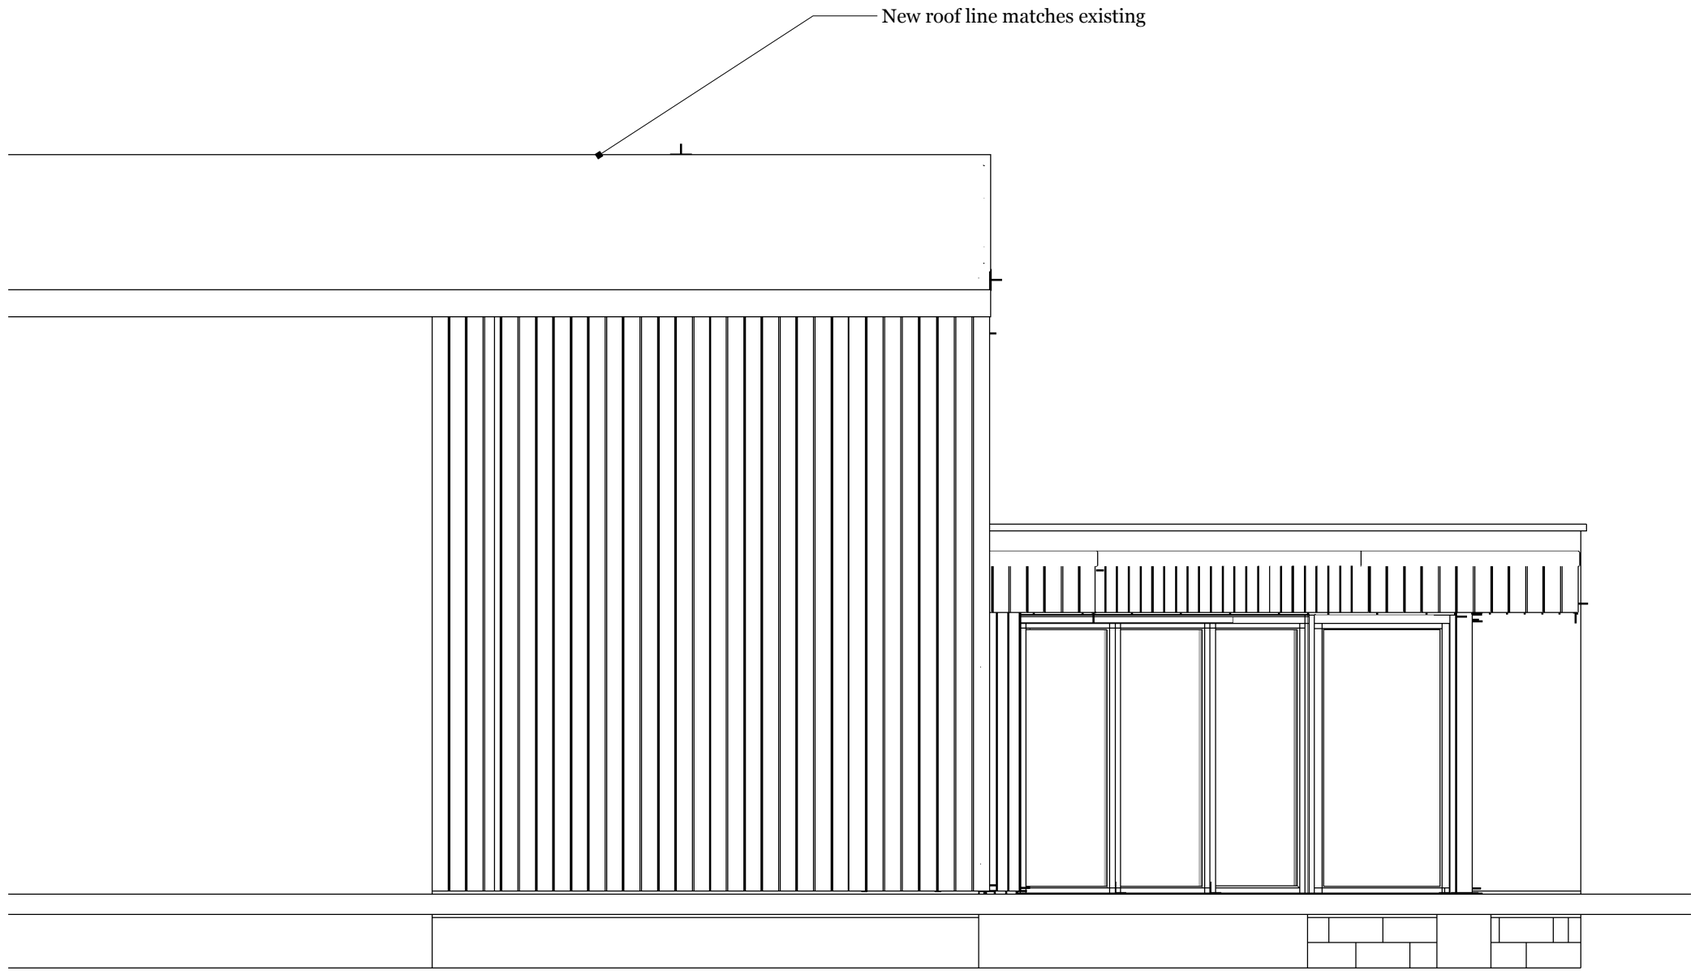


East Elevation
scale: 1:50

E
01

1 2 3 4 5 10

N

SCALE 1:50

As built drawing including alteration from curved to straight Bi fold Doors as per pre application submission of October 2022.
Scale 1:50

C D WOODWORKING

Mr and Mrs Cr Duringer, 68 Pavenhill, Purton, SN5 4DA

FOSYC E01

	MM/DD/YY	REMARKS
1	08/08/2020	Addition of rear glass single storey extension to rear of house.
2	29/01/2023	East Elevation showing change to straight Bi fold doors.
3	__/__/__	...
4	__/__/__	...
5	__/__/__	...

E 01a