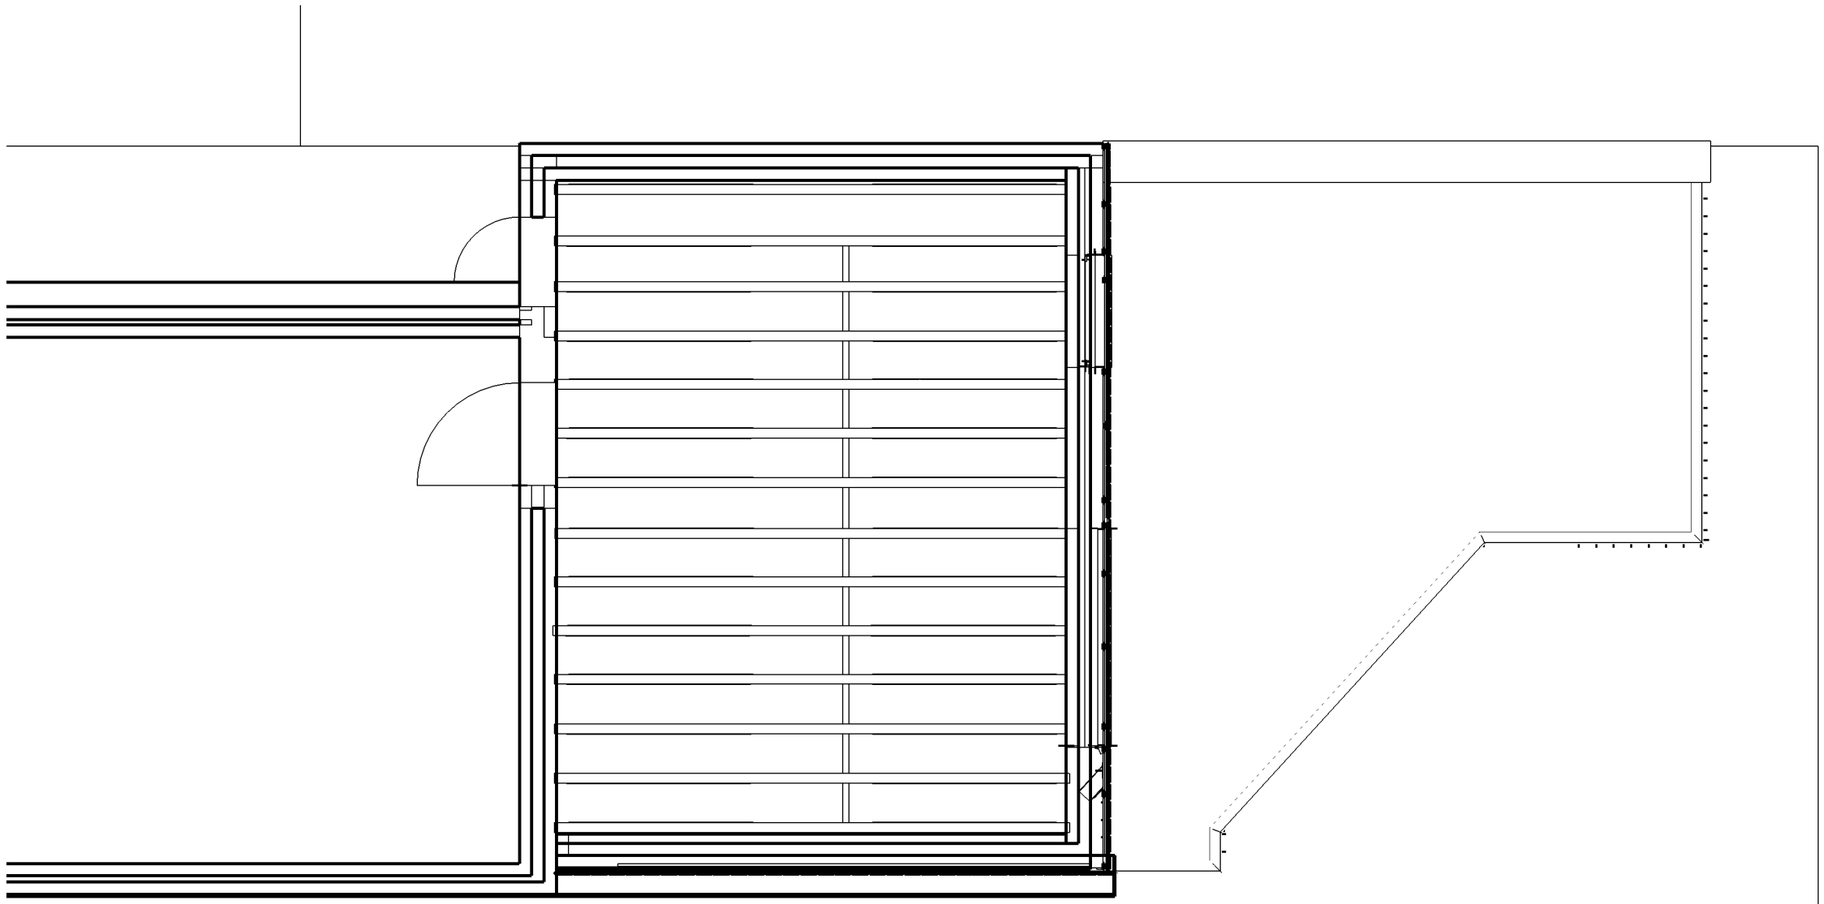


FIRST FLOOR PLAN

scale: 1:50

B
01

1 2 3 4 5 10

N

SCALE 1:50

As built drawing showing first floor bedroom layout and flat roof over kitchen
Scale 1:50

C D WOODWORKING

Mr and Mrs Cr Duringer, 68 Pavenhill, Purton, SN5 4DA

REVISIONS V2

	MM/DD/YY	REMARKS
1	08/08/2020	Addition of rear glass single storey extension to rear of house.
2	29/01 /2023	As built first floor extension as per original drawings.
3	_ _/_ _/_ _	...
4	_ _/_ _/_ _	...
5	_ _/_ _/_ _	...

B 01a