

North Boundary Elevation prior to new gates and fence

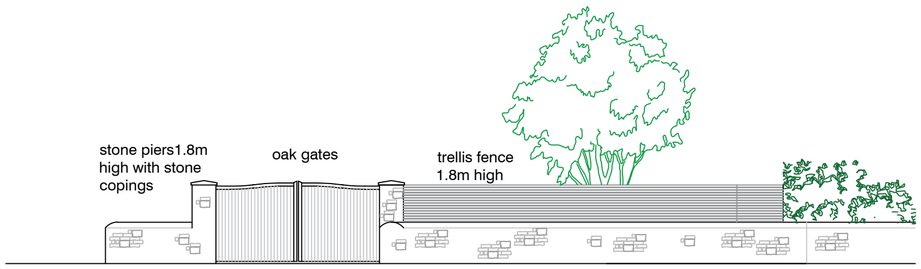

North Boundary Elevation as built

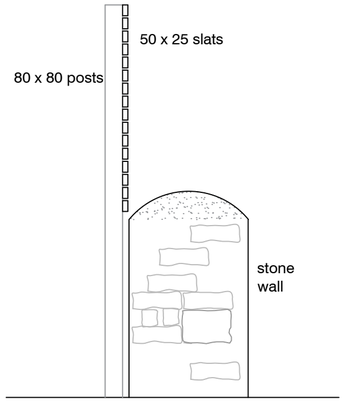

Section through Boundary Wall/Fence - scale 1:20

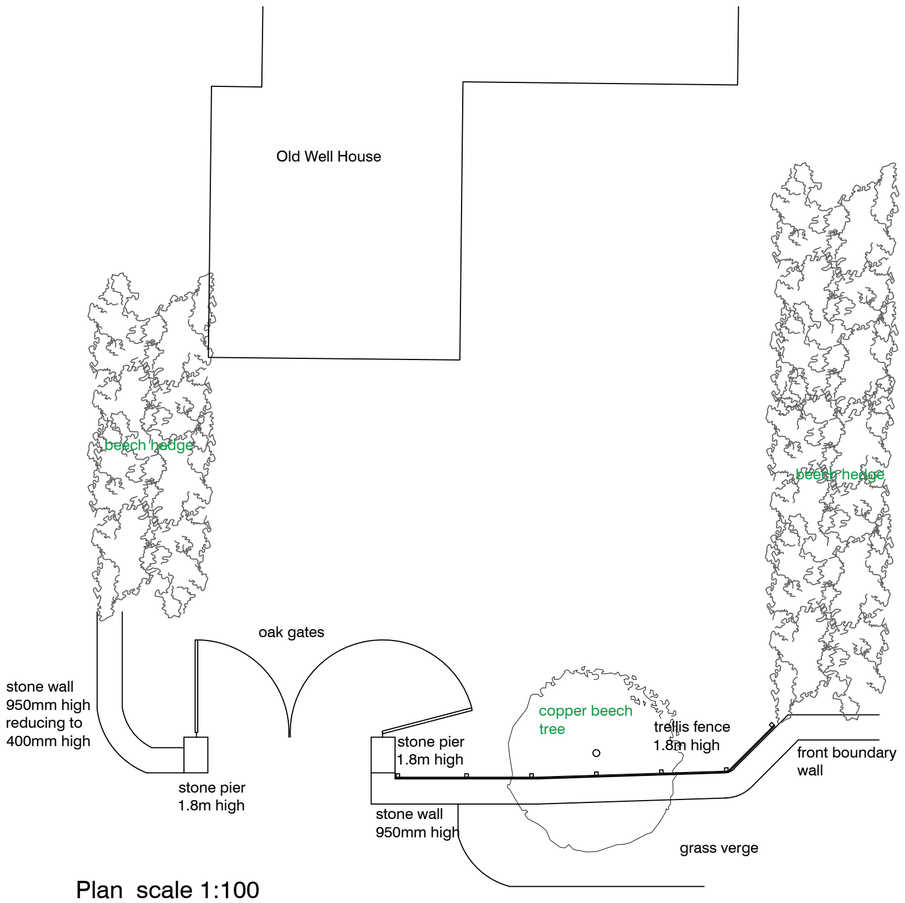

Plan scale 1:100

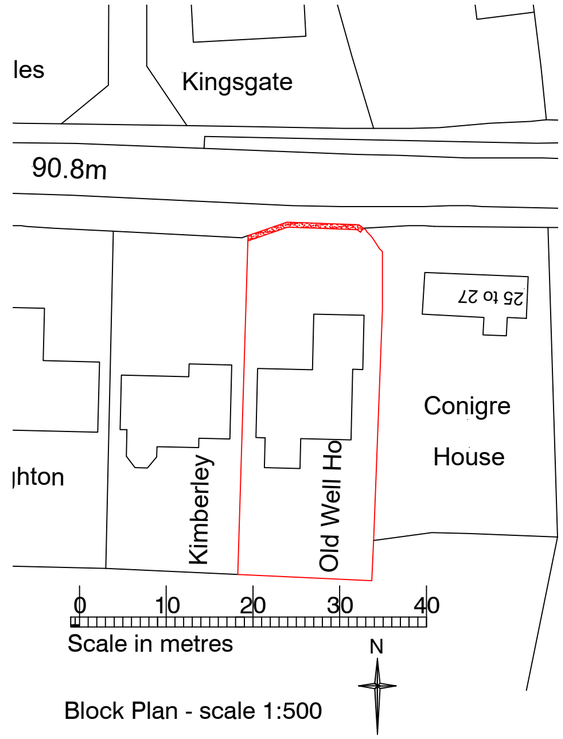

Block Plan - scale 1:500

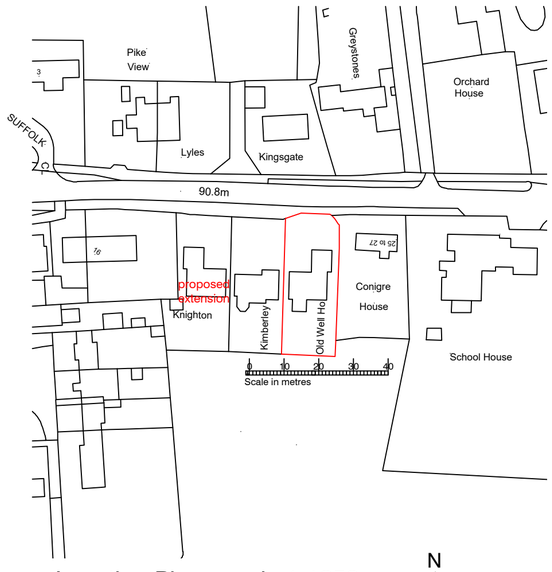

Location Plan - scale 1:1250

Peter A Marshall Architect Limited

2 Halfpenny Close, Twigworth
Gloucester GL2 9GX

Tel: 07836 708219
www.peteramarshall.co.uk
Email: info@peteramarshall.co.uk

Client

MR & MRS C DUFF

Job Title

Old Well House
The Street
Charlton
Malmsbury
Wilts
SN16 9DL

Drawing Title

retrospective planning proposals

Scale	Date	Drawn
as shown @ A2	22.10.2023	pam

23	43	01

A2 drawing sheet