TREATED SOFTWOOD GATES HUNG ON TREATED 200mm TIMBER SQ POSTS
WITH GALVANISED STEEL DOUBLE STRAP GATE HINGE SETS

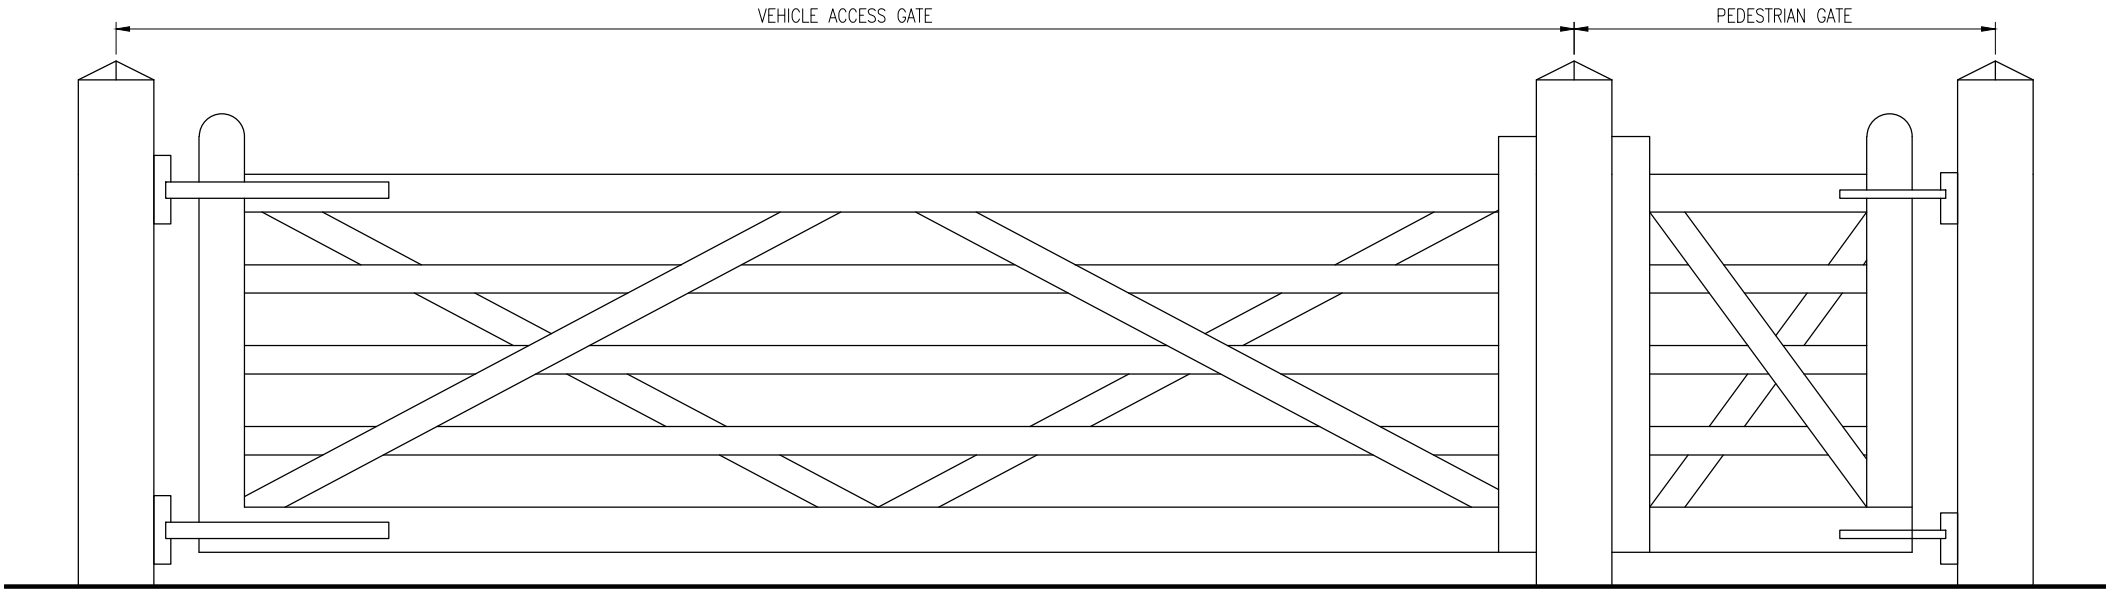

AS BUILT 5 BAR GATES

BLUEBELLS BARN, BULLOCKS HORN, CHARLTON

AS BUILT ENTRANCE GATE DETAIL

Scale
1:20 @ A4

Date
November 2023

Project and Drawing No.
COB/22/001 - 102

© All Rights Reserved

Email: chris@cobriencs.co.uk T: 07722698847
Web: www.cobriencs.co.uk
Chris O'Brien Surveyors Ltd. Company Registration 3873373

CHRIS O'BRIEN Chartered Surveyors

RICS®