THIS DRAWING IS COPYRIGHT
Check all dimensions on site

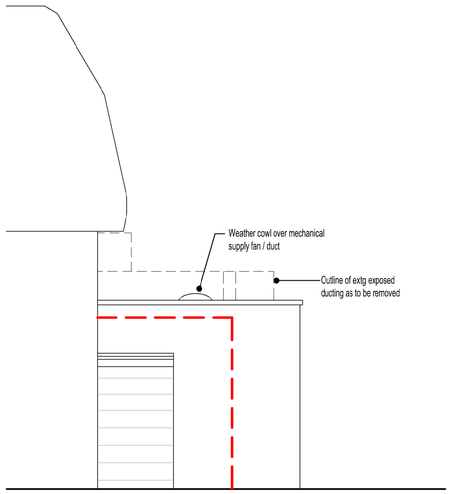

NORTH ELEVATION

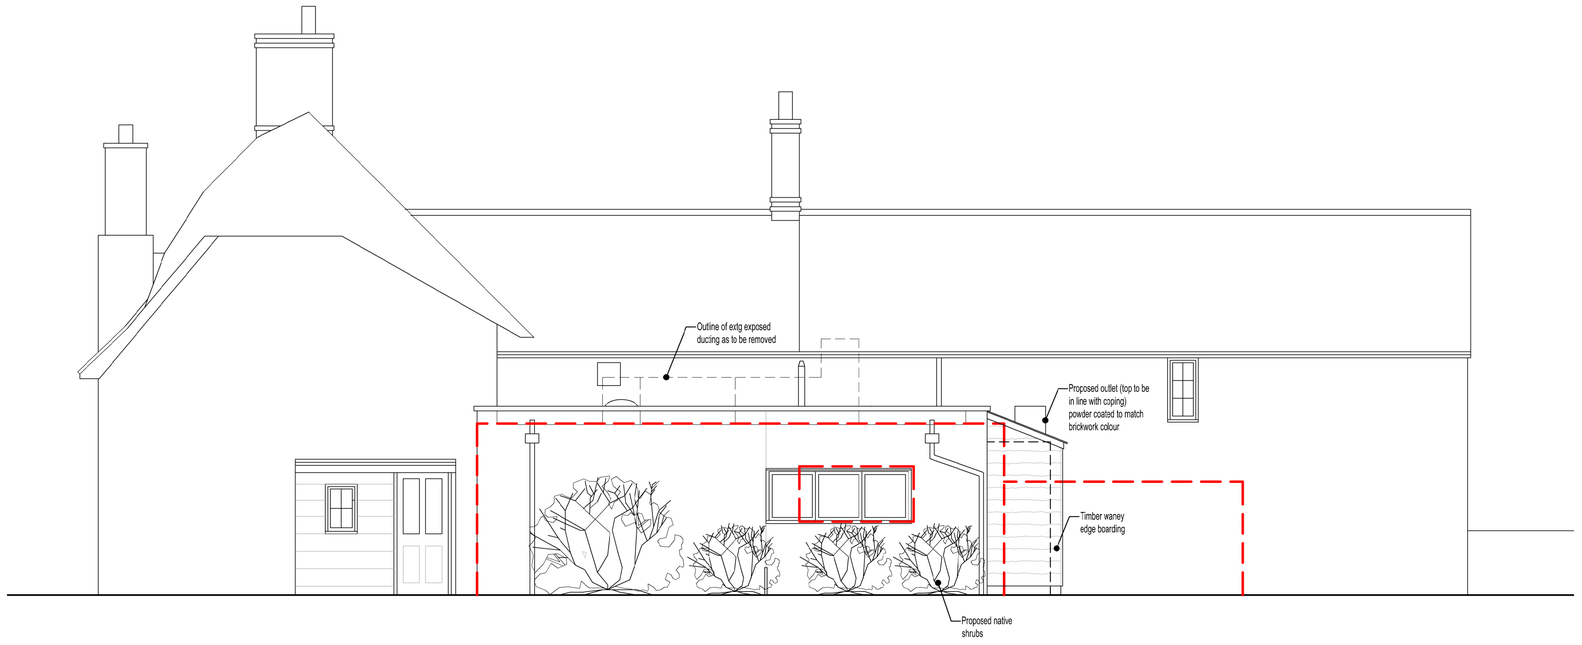

WEST ELEVATION

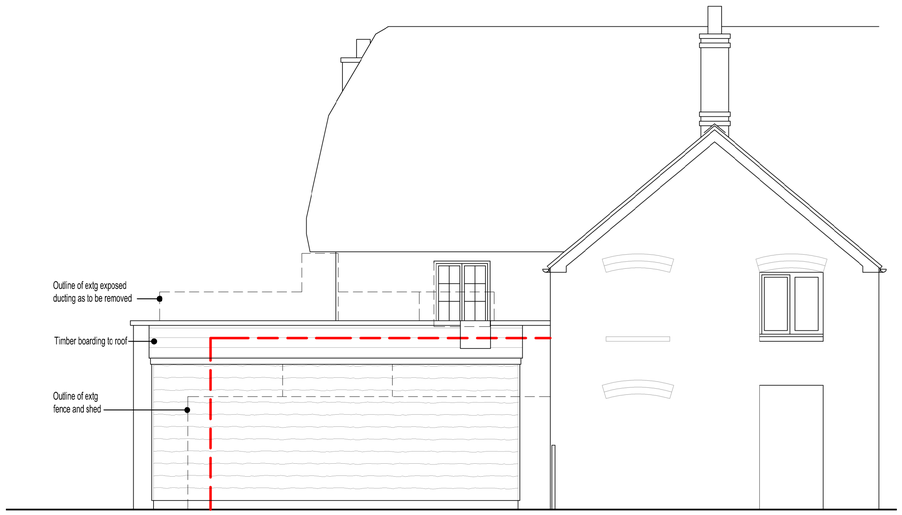

SOUTH ELEVATION

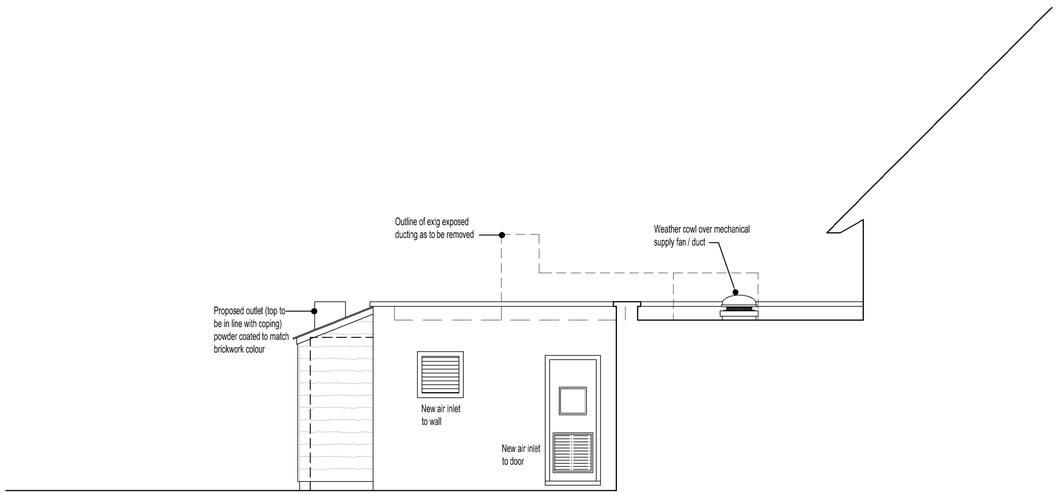

EAST ELEVATION

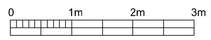

Scale bar (1:50)

Rev.	Date		Init
C	25.01.2024	Timber waney edge cadding and native shrubs added.	JG
B	24.01.2024	Extraction system amended & timber enclosure added.	JG
A	04.12.2023	Approved scheme (PL/2022/00743) & (PL/2022/00202) indicated in red dashed line.	JG

CLIENT
WADWORTH & Co. Ltd

PROJECT
THE LAMB INN, THE GREEN, URCHFONT SN10 4QU

DRAWING
KITCHEN VENTILATION PLANT - PROPOSED ELEVATIONS -

DRAWN:	Date:	Scale:
AWRH	JUL 2023	1:50 @ A1

Drawing number: **4035-05** Rev. **C**

DOLMAN
ARCHITECTURAL DESIGNERS BUILDING SURVEYORS
COST CONSULTANTS CDM PRINCIPAL DESIGNERS
Sussex House
Bath Road
Devizes
Wiltshire SN10 2AF
Tel: 01380 729456
Web: www.dolmansurveyors.co.uk
Email: info@dolmansurveyors.co.uk