THIS DRAWING IS COPYRIGHT
Check all dimensions on site

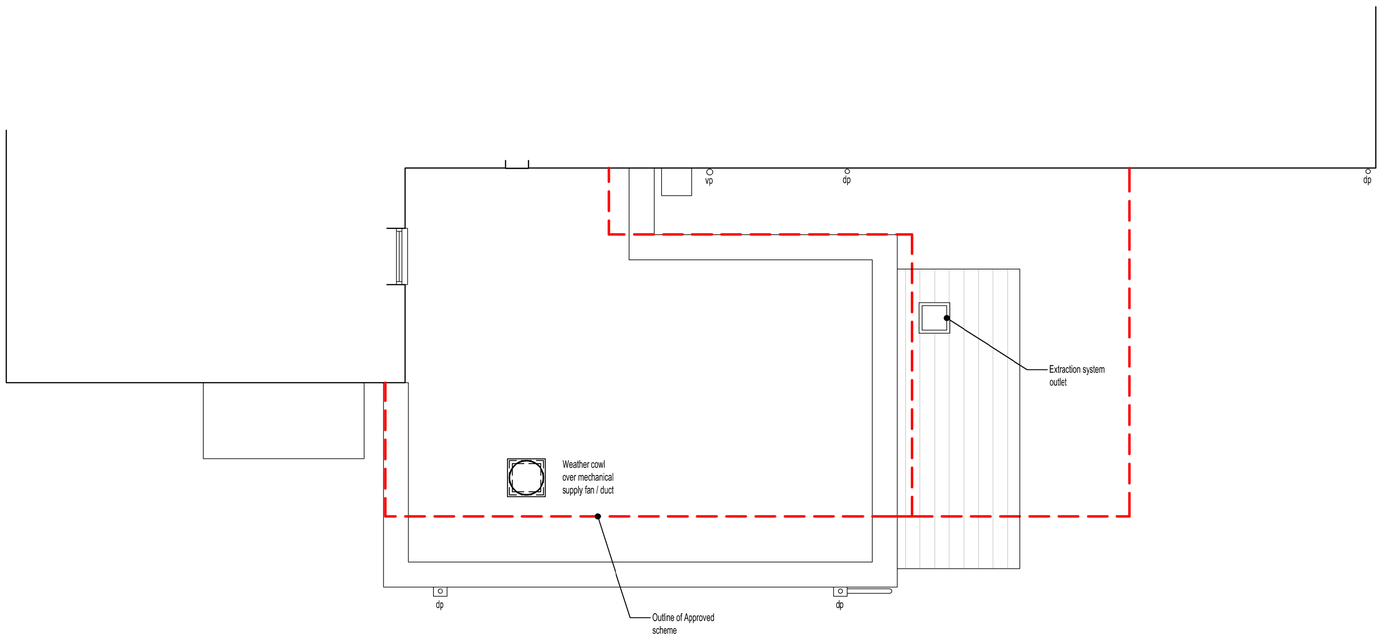

PLAN AT KITCHEN ROOF LEVEL

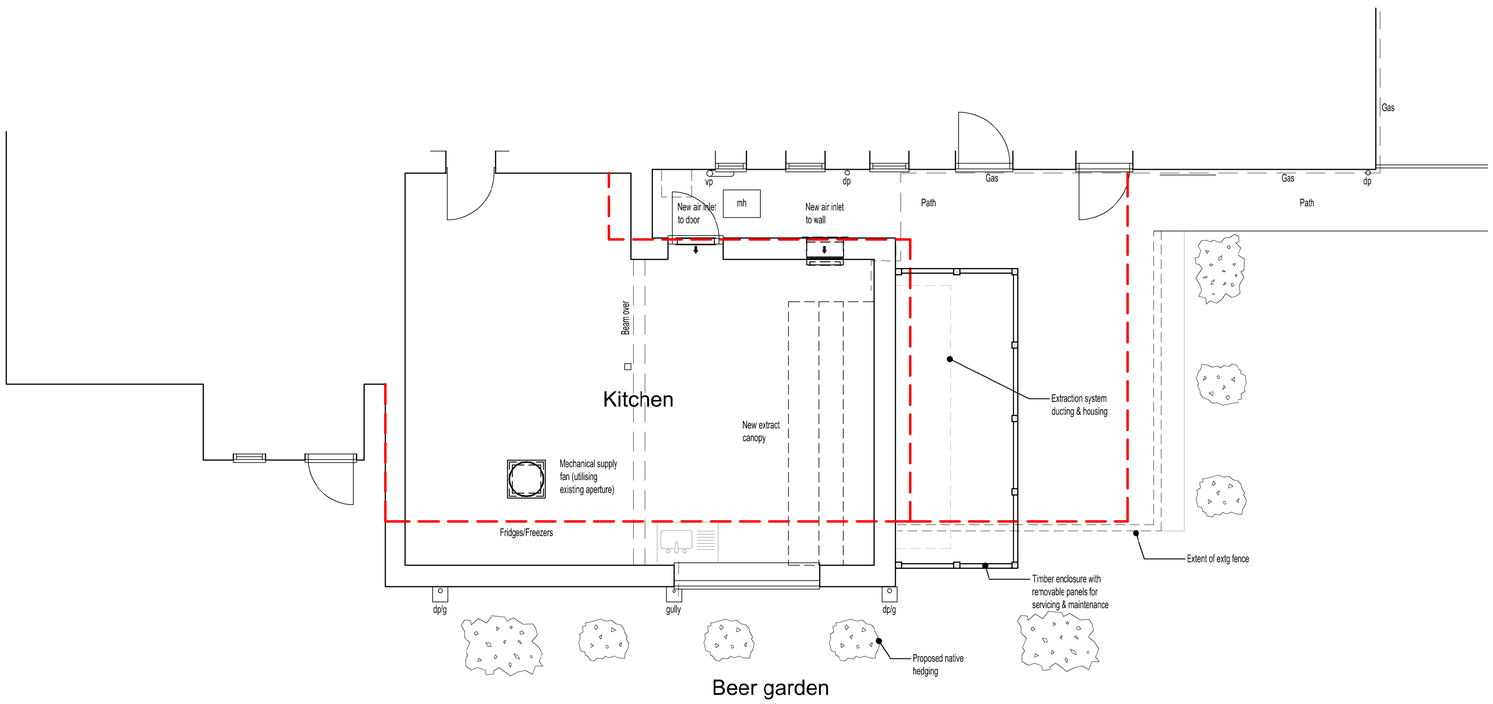

PLAN OF KITCHEN AND SURROUNDINGS

0 1m 2m 3m

Scale bar (1:50)

Rev.	Date		Init
F	21.02.2024	Additional planting added.	JG
E	15.02.2024	Timber lean to building amended.	JG
D	25.01.2024	Native hedging added.	JG
C	24.01.2024	Extraction system amended & timber enclosure added.	JG
B	04.12.2023	Approved scheme (PL/2022/00743) & (PL/2022/00202) indicated in red dashed line.	JG
A	25.09.2023	Notes added.	JG

CLIENT
WADWORTH & Co. Ltd

PROJECT
THE LAMB INN, THE GREEN, URCHFONT SN10 4QU

DRAWING
KITCHEN VENTILATION PLANT - PROPOSED PLANS -

DRAWN:	Date:	Scale:
AWRH	JUL 2023	1:50 @ A1

Drawing number: **4035-04** Rev. **F**

DOLMAN
ARCHITECTURAL DESIGNERS BUILDING SURVEYORS
COST CONSULTANTS CDM PRINCIPAL DESIGNERS
Sussex House
Bath Road
Devizes
Wiltshire SN10 2AF
Tel: 01380 729456
Web: www.dolmansurveyors.co.uk
Email: info@dolmansurveyors.co.uk