
Flat roof and parapet raised above original dimensions to comply with building regulations and insulation depth in order to meet new R values in accordance with BCO requirements.

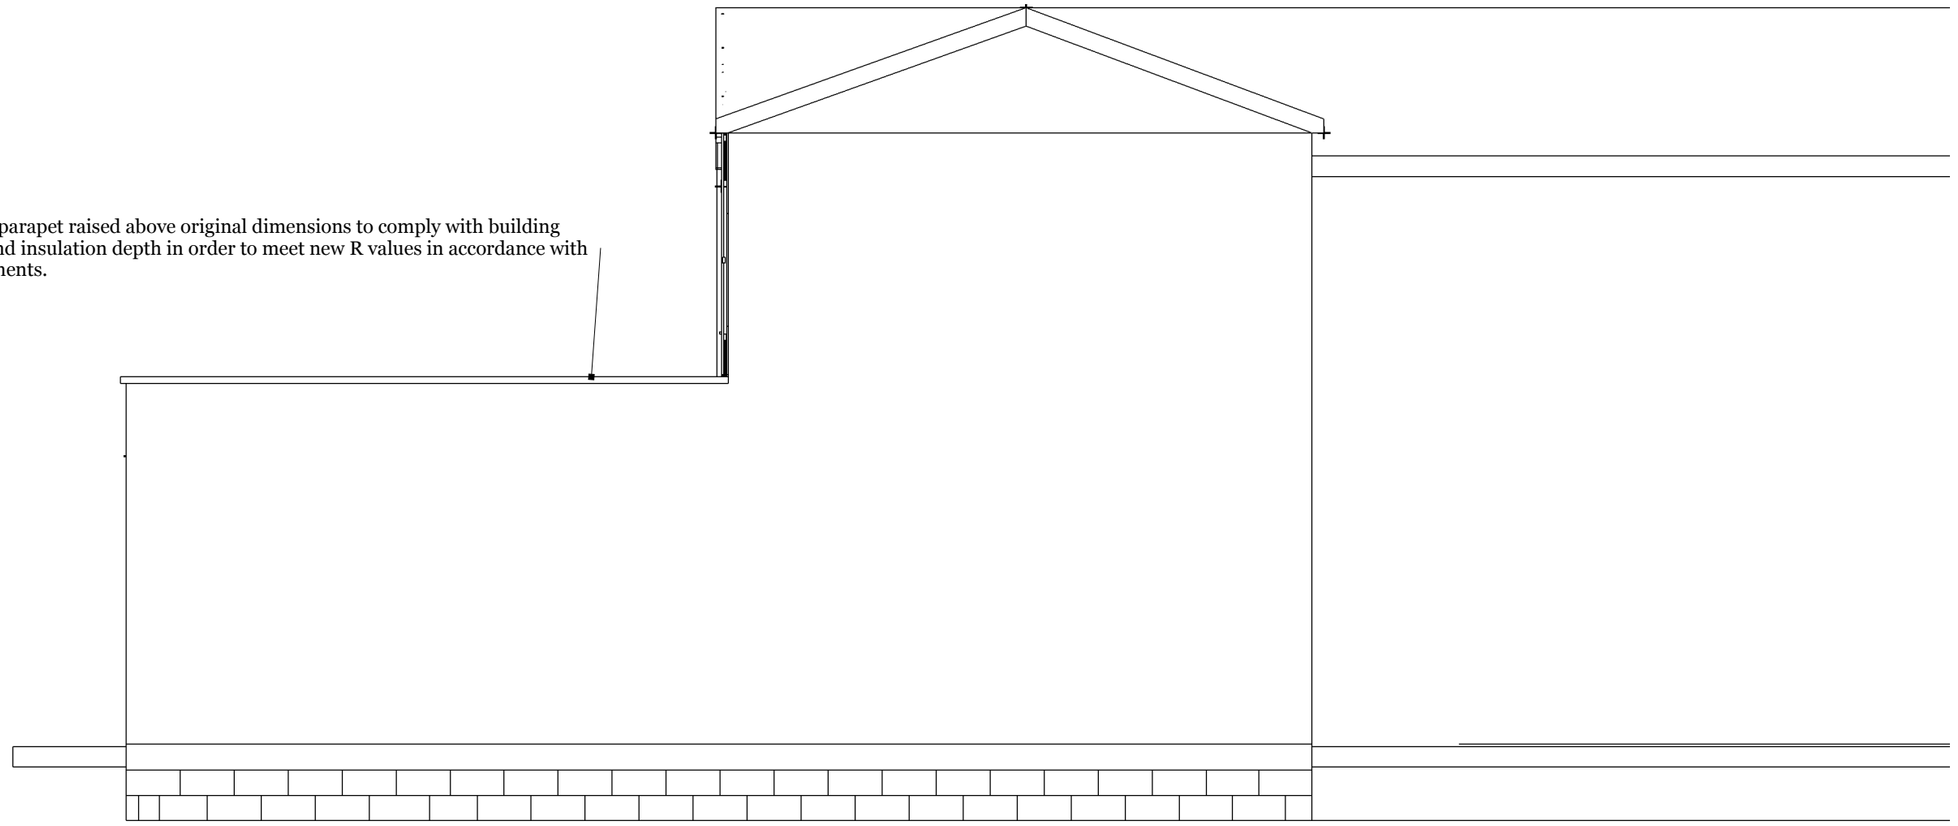

WEST ELEVATION

F
01

scale: 1:50

1 2 3 4 5 10

N

SCALE 1:50

Drawing represents building as constructed in accordance with planning permission and pre application submission with minor measurement amendments to roof height to comply with updated Building regulation R values.

Scale 1:50

C D WOODWORKING

Mr and Mrs Cr Duringer, 68 Pavenhill, Purton, SN5 4DA

REVISIONS

	MM/DD/YY	REMARKS
1	08/08/2020	Addition of rear glass single storey extension to rear of house.
2	29/01/2023	West Elevation as per planning permission.
3	__/__/__	...
4	__/__/__	...
5	__/__/__	...

01

F