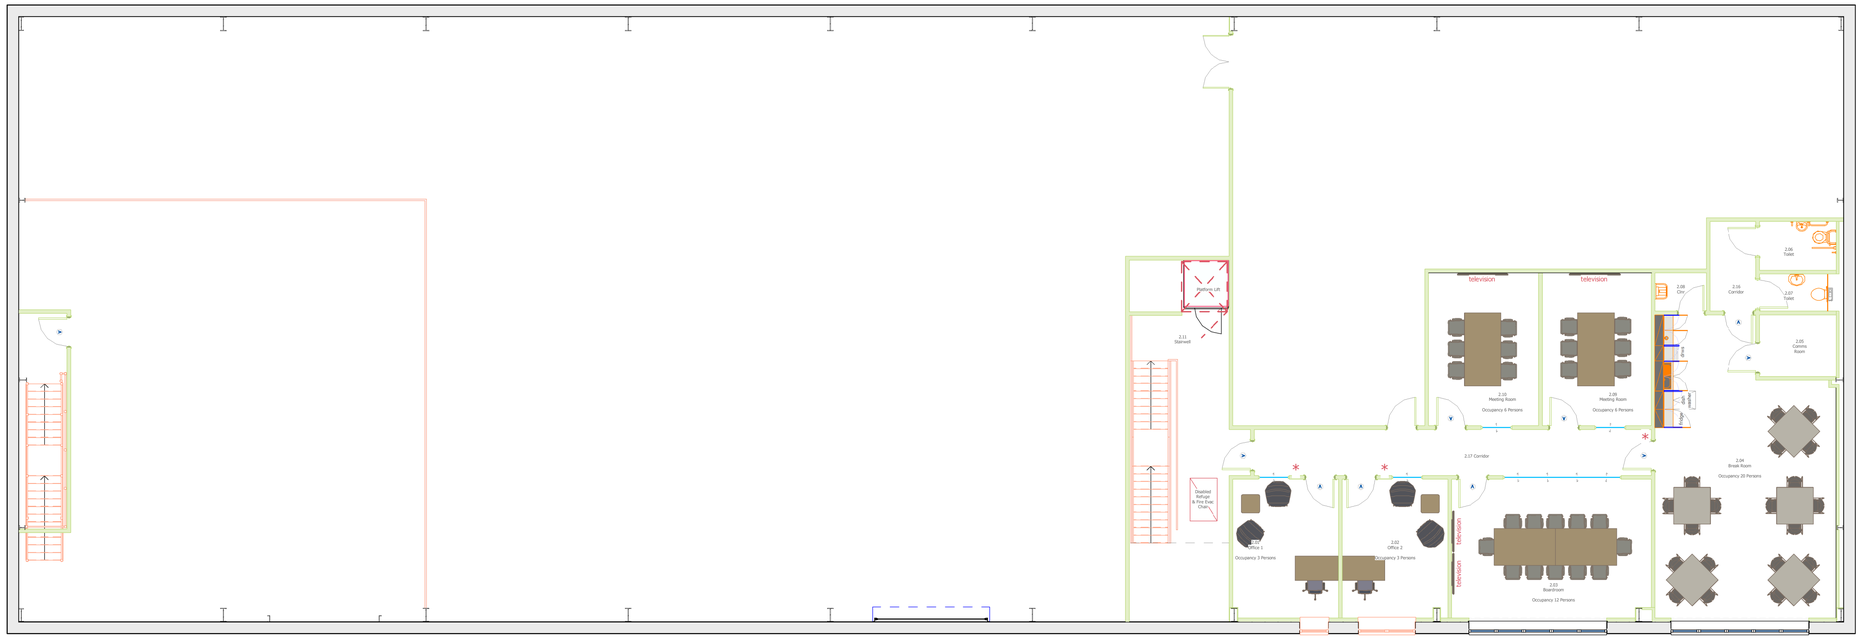

FIRST FLOOR
AS PROPOSED

Regulations:
All new glazing to comply with the requirement N1 and N2 Building Regulations.

All new fire safety means of warning and escape to comply with the requirement B1 Building Regulations and BS5839.

Project Revisions:
B- 30/10/23 LM
Additional door into the first floor mothball space added
C - 10/11/23 LM
Existing entrance door to remain and to be locked. Additional detail added to specification.
D - 16/11/23 LM
Lab 6 and wash prep room positions swapped. Door swing adjustments and architectural drawing amends
E - 1/12/23 LM
Existing door positions amended following survey, partition amends to suit. Equipment amendments.
F - 15/12/23 LM
Cleaners cupboard doors opened inwards, additional design items added.
G - 02/01/24 LM
Ductwork update, wall around lift added to first floor. Design finishes amendments to doors and flooring.
H - 01/01/24 LM
Updates to ceilings, furniture and tea points
I - 28/02/24 LM
Roof line amended to as built.
J - 03/04/24 LM
Partiton amends to as built, signage added.

Sheet Revisions:
A- 00/00/00

McFeggan Brown

1290 Park Avenue, Aztec West,
Almondsbury, Bristol, BS32 4SG
Telephone | 01275 464 220
Web | www.mcfegganbrown.co.uk
Email | sales@mcfegganbrown.co.uk

Client: Project Scaffold

Site: Corsham
Business Park

Title: GENERAL
ARRANGEMENT

As BUILT

Drawing Issue: AS BUILT

Date: 05/04/2024 | Drawn By: LM

Scale: 1:100 @ A1 | Checked By:

Project No: 4643 | Rev: J | Sheet: 112 - | Floor: First

All dimensions to be checked on site before work commences.

All drawings and written material herein constitute the original works of the designer, and may not be duplicated, used, or disclosed without the written consent of McFeggan Brown.