
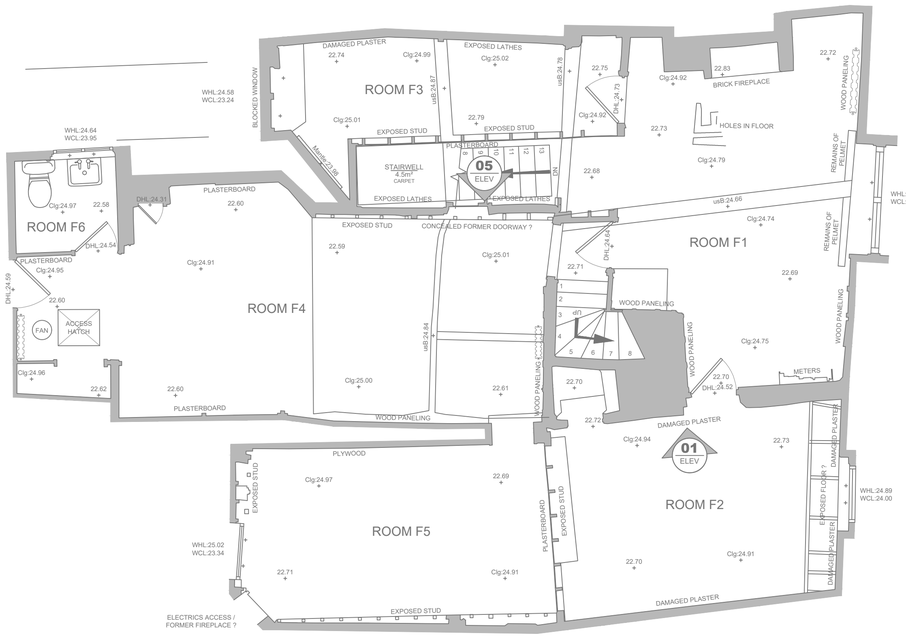



EXISTING FIRST FLOOR PLAN (INDICATING ELEVATION MARKS)

Scale 1:50

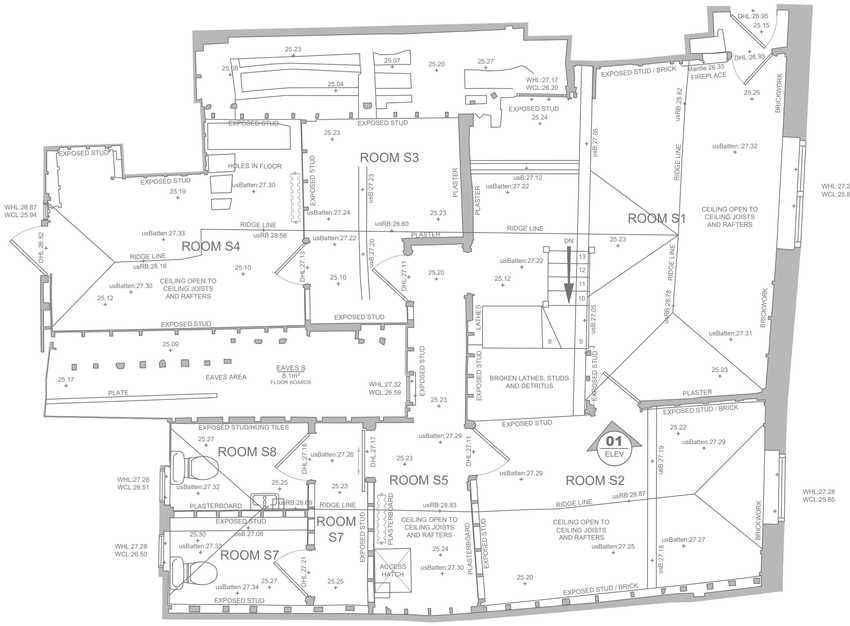

EXISTING SECOND FLOOR PLAN (INDICATING ELEVATION MARKS)

Scale 1:50

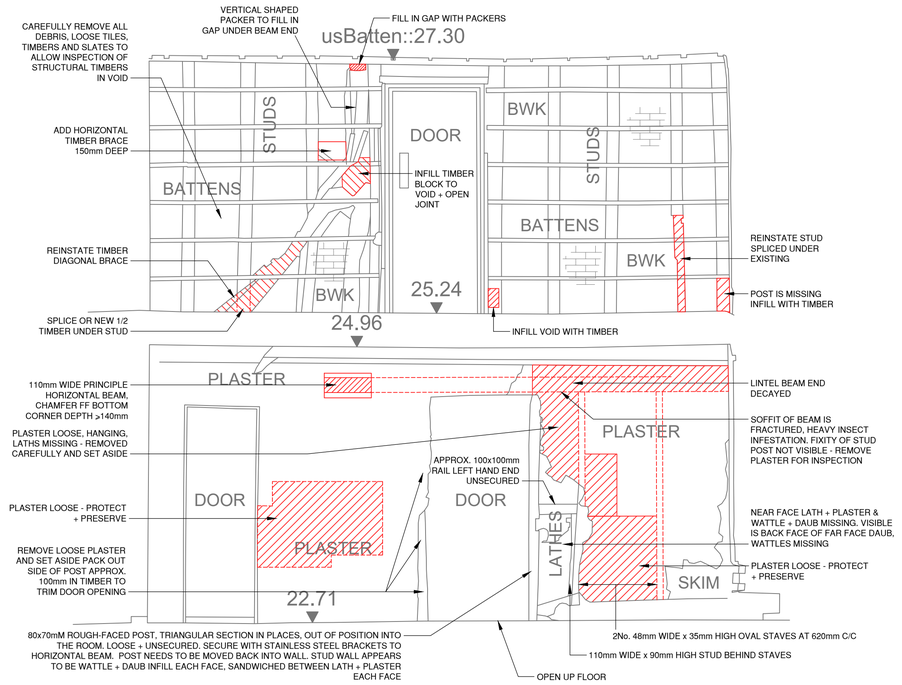


STRIP LOOSE HANGING PLASTER SET ASIDE, TO ALLOW INSPECTION OF TIMBER STUDS, PROBE WHOLE AREA, AND DECAYED LINTEL BEAM END.

PRESERVE LATHES WHERE THEY ARE SOUND AND ANY AREAS OF SOUND PLASTER

INTERNAL WALL ELEVATION 01

Scale 1:25

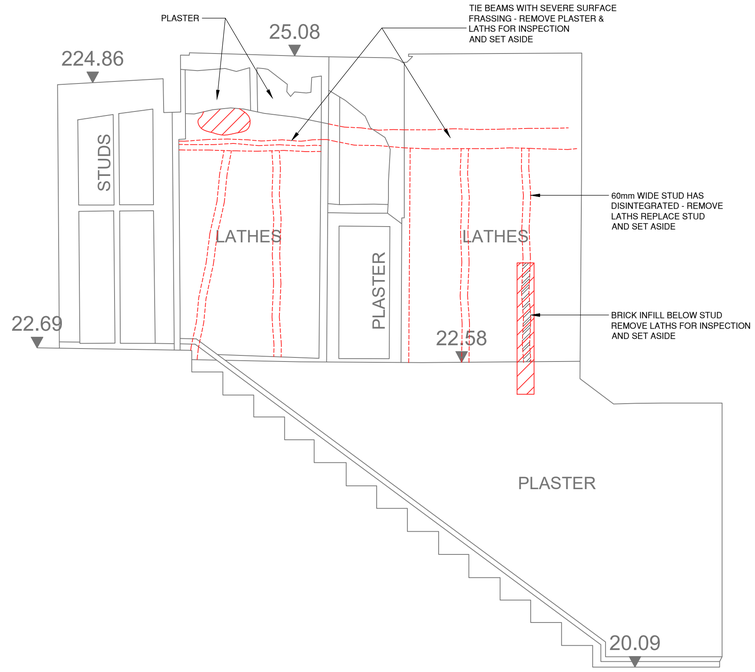

INTERNAL WALL ELEVATION 05

Scale 1:25

PRELIMINARY

GENERAL

G1. DO NOT SCALE THIS DRAWING, USE ONLY WRITTEN DIMENSIONS. ANY DISCREPANCIES TO BE REPORTED TO THE ENGINEERS. IF IN DOUBT ASK.

G2. SETTING OUT TO ARCHITECT'S DRAWINGS.

G3. THIS DRAWING IS TO BE READ IN CONJUNCTION WITH ALL OTHER RELEVANT ARCHITECTS, ENGINEERS, AND SPECIALISTS DRAWINGS, AND WITH THE SPECIFICATIONS.

G4. WORKS TO COMPLY WITH ALL RELEVANT BRITISH STANDARDS, CODES OF PRACTICES, EURO CODES AND THE BUILDING REGULATIONS.

G5. THE CONTRACTOR SHALL BE RESPONSIBLE FOR MAINTAINING THE STRUCTURAL INTEGRITY OF THE WORKS AT ALL TIMES BY THE PROVISION OF ADEQUATE TEMPORARY WORKS.

G6. ALL DIMENSIONS IN MILLIMETERS (mm), ALL LEVELS IN METRES (m).

KEY:

INDICATES APPROXIMATE EXTENTS OF OPENING UP WORKS REQUIRED AS AGREED WITH CONSERVATION OFFICER 29/08/2024

SAFETY HEALTH AND ENVIRONMENTAL INFORMATION BOX

Construction Risks	Maintenance Risks	Demolition/Adaption Risks

The table above is provided to assist the Principal Contractor to fulfil his obligations under the Construction (Design & Management) Regulations 2015. It does not include residual risks that a competent Contractor will be aware of nor does it absolve the Principal Contractor of his legal responsibilities.

REVISIONS

Mark	Date	Details	By
P2	17/09/24	OPENING UP WORKS INDICATED IN RED ROOM NUMBER ADDED	MW
P1	22/04/24	ISSUE FOR INFORMATION	MW

General Notes:

1. THIS DRAWING IS TO BE READ IN CONJUNCTION WITH ALL SCHEME DRAWINGS AND DESIGNERS RISK ASSESSMENTS
2. UNLESS NOTED OTHERWISE ALL DIMENSIONS ARE IN MILLIMETERS & ALL LEVELS ARE IN METERS RELATIVE TO ORDNANCE DATUM.
3. CONTRACTOR TO CHECK ALL DIMENSIONS ON SITE PRIOR TO CONSTRUCTION AND/OR FABRICATION, AND ANY DISCREPANCIES TO BE REPORTED BACK TO CLEGG ASSOCIATES BEFORE PROCEEDING

Client:

Drawing Originator:

CIVIL & STRUCTURAL ENGINEERING
clegg

Drawn By:	Checked By:	Approved By:	Date:	Scale:
PMJ	MW	MW	22/04/24	AS NOTED

Drawing Suitability:

S2 - ISSUE FOR INFORMATION

Do NOT scale this drawing. Refer to Architects drawings for building layouts

Project Title:

14 HIGH STREET
SALISBURY

Drawing Title:

EXISTING SECTION
OPENING UP WORKS

CLEGG Asso.	Drawing No:								Revision:
Job No:	Project	Origin.	Volume	Level	Type	Discip.	Number		
2024-024	HSS	CAL	ZZ	ZZ	DR	S	1002		P2