
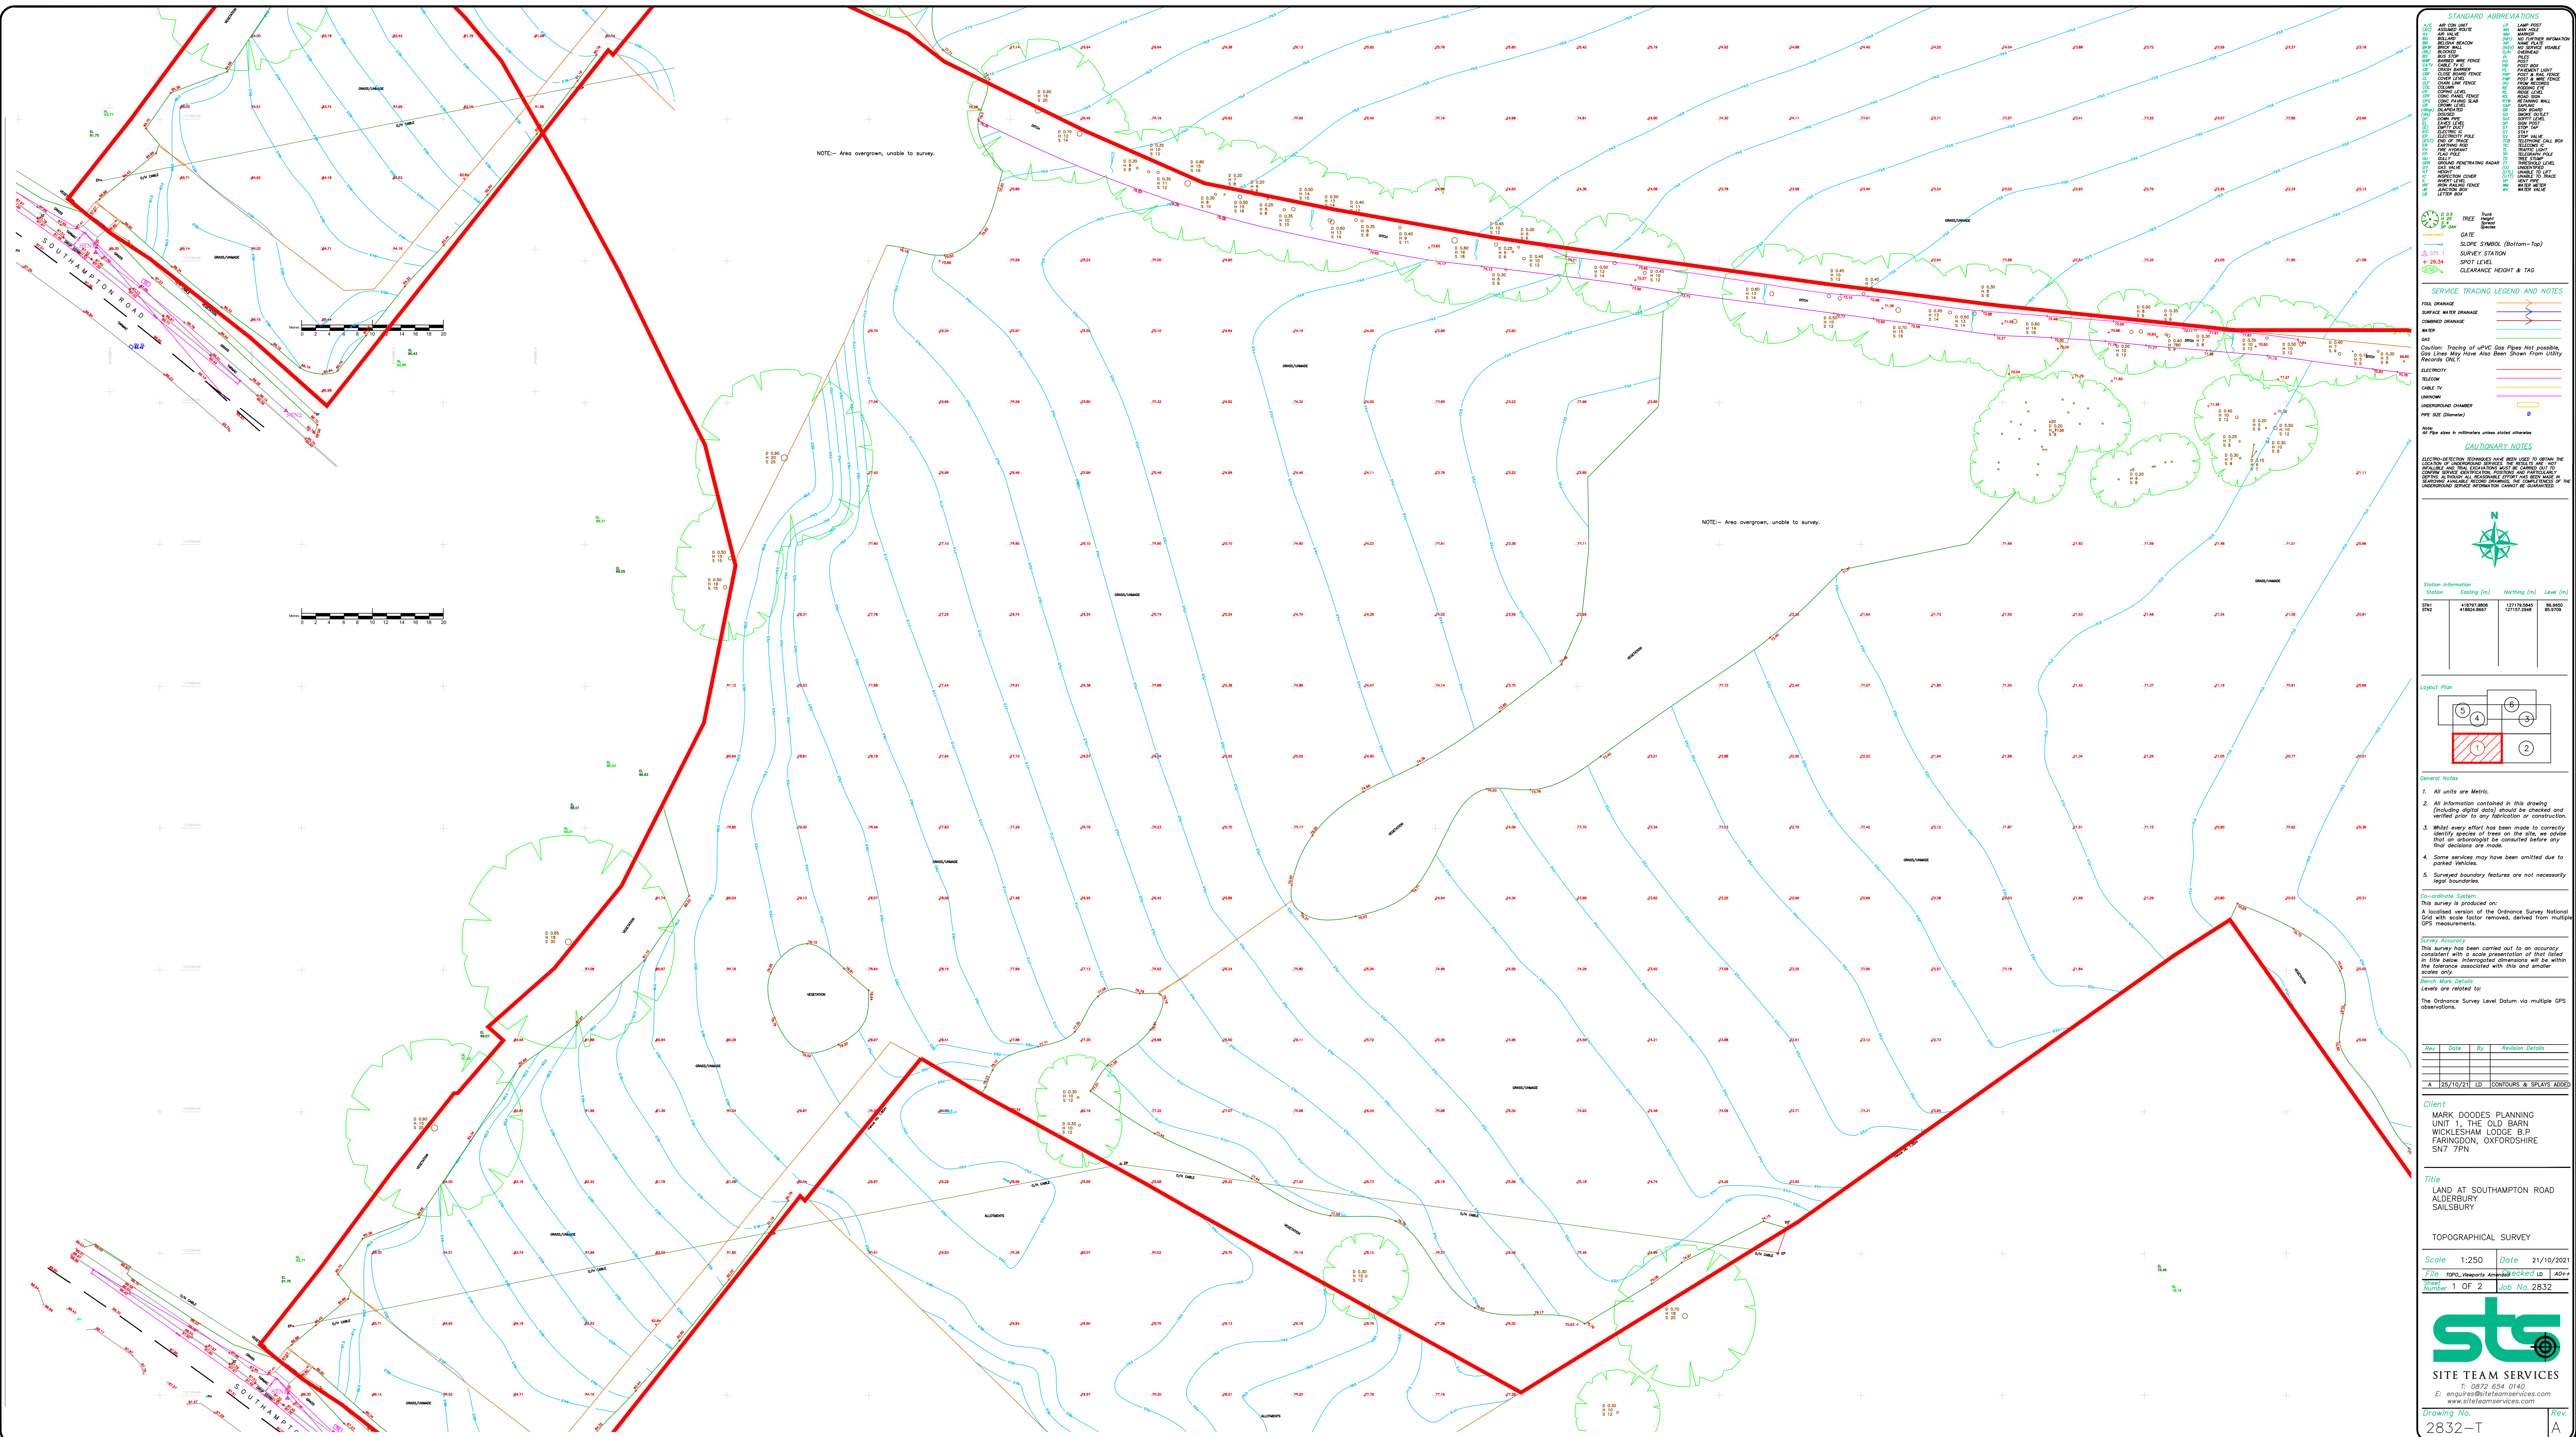


A0 ++

 

[illegible]

TREE Trunk  
 Height  
 Survival  
 Species  
 GATE  
 SLOPE SYMBOL (Bottom=Top)  
 SURVEY STATION  
 SPOT LEVEL  
 CLEARANCE HEIGHT & TAG

### SERVICE TRACING LEGEND AND NOTES

FULL DRAINAGE  
SURFACE WATER DRAINAGE  
COMBINED DRAINAGE  
SEWER  
GAS  
Caution: Tracing of sPVC Gas Pipes Not possible,  
Gas Lines May Have Also Been Shown From Utility  
Records ONLY.

ELECTRICITY  
TELEPHONE  
CABLE TV  
UNKNOWN


UNDERGROUND CHAMBER

PIPE SIZE (Diameter)


Note:

**CAUTIONARY NOTES**

ELECTRO-DETECTION TECHNIQUES HAVE BEEN USED TO OBTAIN THE LOCATION OF UNDERGROUND SERVICES. THE RESULTS ARE NOT RELIABLE AND FINAL EXCAVATIONS MUST BE CARRIED OUT TO CONFIRM SERVICE IDENTIFICATION, POSITIONS AND PARTICULARLY DEPTHS. ALTHOUGH ALL REASONABLE EFFORT HAS BEEN MADE IN SEARCHING AVAILABLE RECORD DRAWINGS, THE COMPLETENESS OF THE UNDERGROUND SERVICE INFORMATION CANNOT BE GUARANTEED.

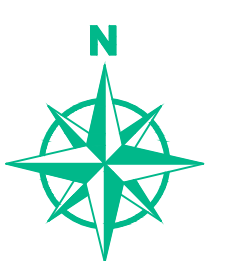

| Station Information |             |              |           |
|---------------------|-------------|--------------|-----------|
| Station             | Easting (m) | Northing (m) | Level (m) |
| STN1                | 418797.9806 | 127179.5845  | 86.9650   |
| STN2                | 418824.8667 | 127157.2948  | 85.9709   |

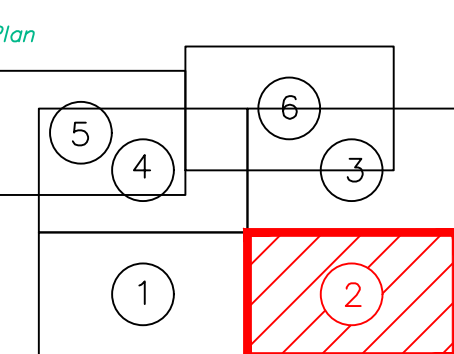

1. All units are Metric.
2. All information contained in this drawing (including digital data) should be checked and verified prior to any fabrication or construction.
3. Whilst every effort has been made to correctly identify species of trees on the site, we advise that an arborologist be consulted before any final decisions are made.
4. Some services may have been omitted due to parked Vehicles.
5. Surveyed boundary features are not necessarily legal boundaries.

**Co-ordinate System**  
This survey is produced on:  
A localised version of the Ordnance Survey National Grid with scale factor removed, derived from multiple GPS measurements.

**Survey Accuracy**  
This survey has been carried out to an accuracy consistent with a scale presentation of that listed in title below. Interrogated dimensions will be within the tolerance associated with this and smaller scales only.

**Bench Mark Details**  
Levels are related to:  
The Ordnance Survey Level Datum via multiple GPS observations.

| Rev | Date | By | Revision Details |
|-----|------|----|------------------|
|     |      |    |                  |
|     |      |    |                  |
*Client*  
MARK DOODES PLANNING  
UNIT 1, THE OLD BARN  
WICKLESHAM LODGE B.P  
FARINGDON, OXFORDSHIRE  
SN7 7PN

**Title**  
LAND AT SOUTHAMPTON ROAD  
ALDERBURY  
SAILSBURY

TOPOGRAPHICAL SURVEY

|       |       |      |            |
|-------|-------|------|------------|
| Scale | 1:250 | Date | 21/10/2021 |
|-------|-------|------|------------|

|              |                    |         |      |      |
|--------------|--------------------|---------|------|------|
| File         | TOPO_Viewports.dwg | Checked | LD   | A0++ |
| Sheet Number | 2 OF 2             | Job No. | 2832 |      |




**SITE TEAM SERVICES**  
T: 0872 654 0140  
E: [enquiries@siteteamservices.com](mailto:enquiries@siteteamservices.com)

|             |      |
|-------------|------|
| Drawing No. | Rev. |
|-------------|------|

2832-T