



Proposed Works:

Remove insulation and flue pipe.


Support over and remove the right hand brick infill.

Clean off soot and tar deposits in accordance with the specification on drawing D.15.

Make good any loose brickwork to match.

Re-construct the hearth with a soft red clay brick set in 1:3 NHL 3.5:sand in a herringbone pattern.

Use 3 no.stainless steel 8mm pins to relocate the stone mantle with the surrounding brickwork.The locations are indicate by a red circle.

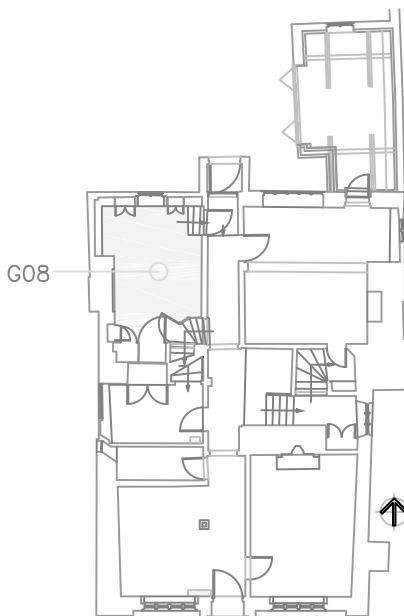

G08 Fireplace.

C17 plain bolecion mouded surround, part covered by C17th oak panelling.

A substantial crack in the joint between the C 17th back brick lining and the stone surround as indicated by a red line.

An insulated steel flue pipe from the cellar fireplace passes through the hearth and lines the chimney.

To the right is a part infill of brickwork and plaster, complete with the remains of a modern section of skirting.

Drawing : **Detail Specifications for repair works to:**

Fireplace - G.08

Revisions : Rev Date

Scale : NTS

Drawn : CP

Date : December 2025

Drawing No.

1306.D.18