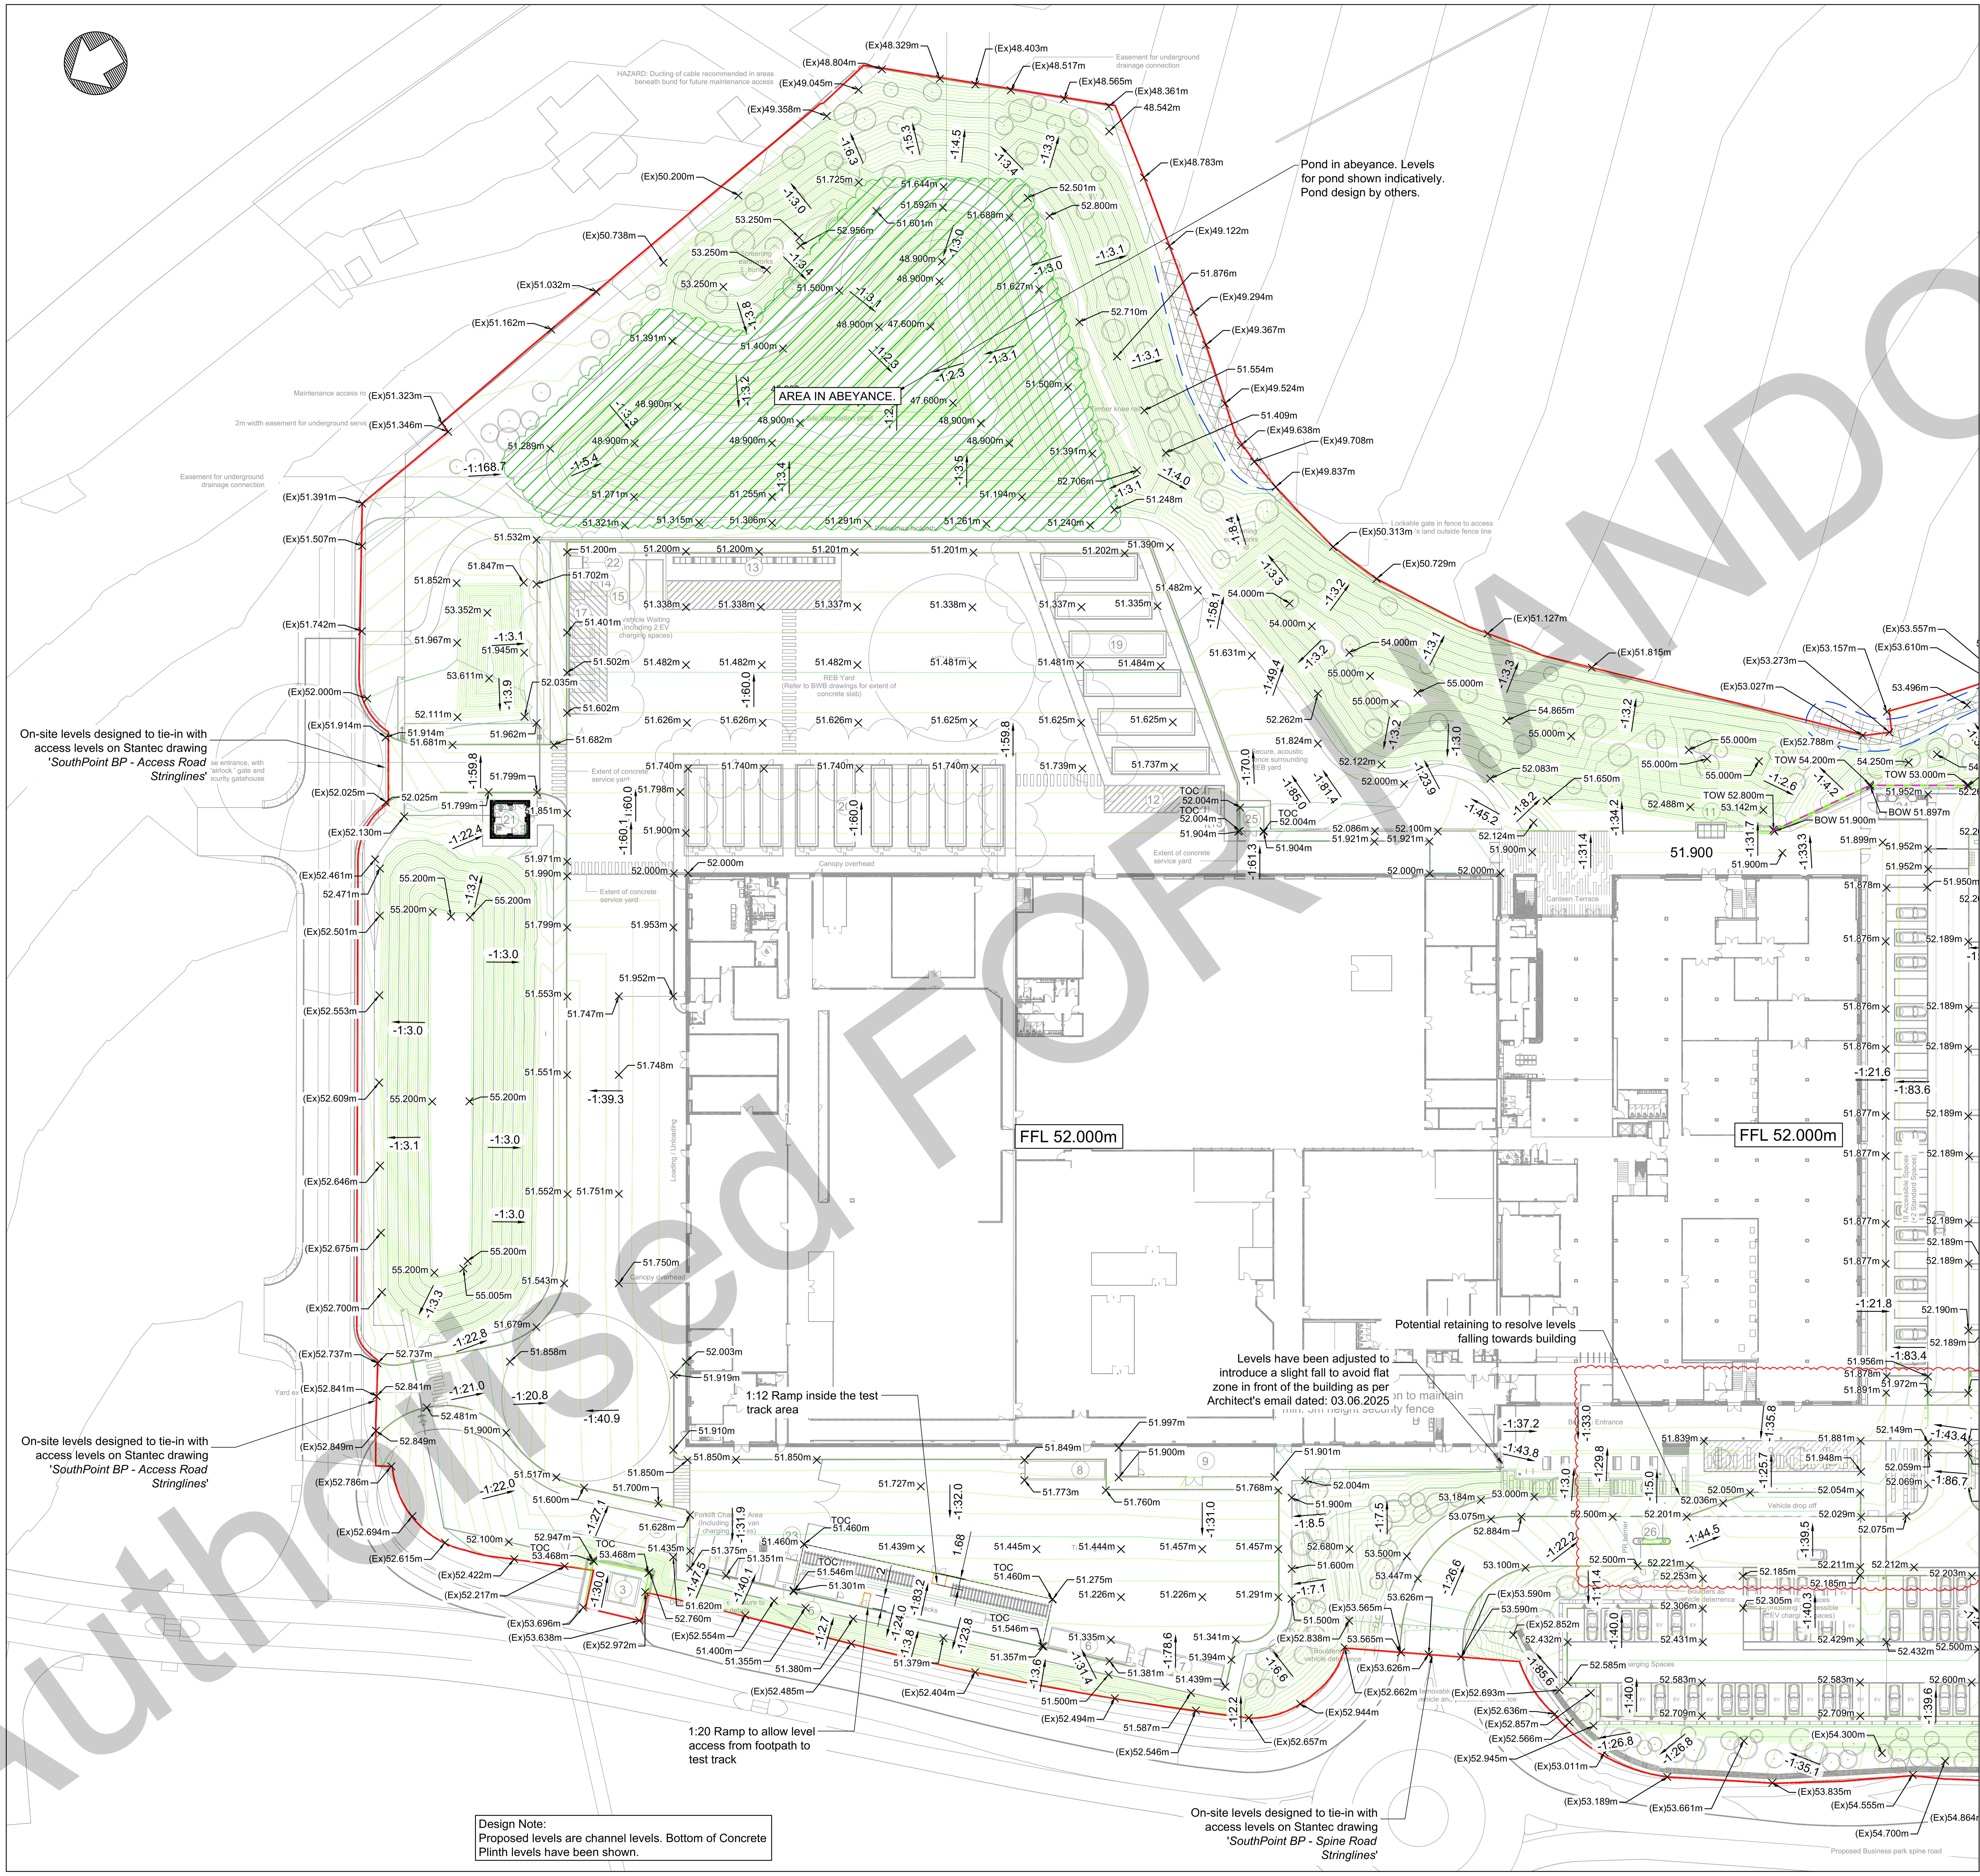


FOR CONTINUATION REFER TO SMC-BWB-ZZ-XX-D-C-0601


AS-BUILT

This "AS-BUILT" drawing represents the final intent of BWB and is offered for incorporation into the Health & Safety File. The "AS-BUILT" drawing records records any amendments made on site by the Contractor only where the details of such amendments have been specifically notified to BWB. BWB rely solely on the Contractor for the provision of the information and BWB accept no responsibility for the accuracy of the information provided by the Contractor. Any discrepancy between this "AS-BUILT" drawing and the completed works should be referred to the Contractor for clarification

Notes

1. Do not scale this drawing. All dimensions must be checked/ verified on site. If in doubt ask.
2. This drawing is to be read in conjunction with all relevant architects, engineers and specialists drawings and specifications.
3. All dimensions in millimetres unless noted otherwise. All levels in metres unless noted otherwise.
4. Any discrepancies noted on site are to be reported to the engineer immediately.
5. Topographical survey based on drawing '407.064531.00001.001.09.0_Chippenham_Topo_0124' issued February 2024.

Key Plan

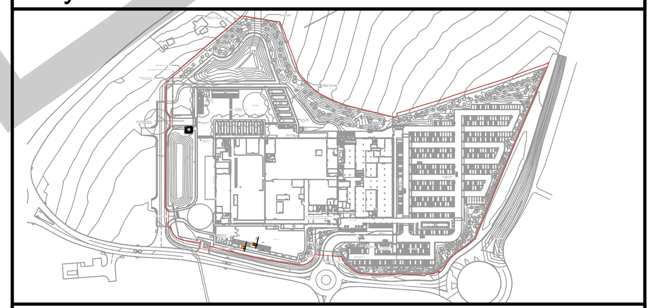

Legend

(red line)	Site Boundary
(line)	Minor Contours at 0.5m Intervals
(line)	Major Contours at 0.1m Intervals
X 92.000m	Proposed Spot Level
X (Ex)92.000m	Existing Spot Level
FFL 92.000m	Proposed Finished Floor Level
1:30	Proposed Gradient
(hatch)	Root Protection Zone
(dashed line)	Root Protection Zone 1m Offset
(dashed line)	Gabion Wall. Structural design TBC.
X BOW 50.000m	Proposed Bottom of Retaining Wall Spot Level
X TOW 52.000m	Proposed Top of Retaining Wall Spot Level

Design Note:
Proposed levels are channel levels. Top of kerb elevations to be derived from external kerbing layout and construction details.

Rev	Date	Details of issue / revision	Drw	Rev
C17	20.02.26	As-Built Issue	ZC	TW
C16	18.11.25	Updated to latest masterplan.	GK	TW
C15	28.10.25	Updated to latest masterplan.	GK	TW
C14	03.10.25	Updated to latest masterplan.	GK	TW
C13	15.09.25	Spot elevations updated.	GK	TW
C12	18.08.25	Nitrogen Trench Added.	GK	TW
C11	07.08.25	Updated to latest masterplan.	GK	TW
C10	10.06.25	Levels outside entrance updated. Test track area updated to show ramp inside.	GK	TW
C9	27.02.25	Construction Issue	GK	TW
C8	20.01.25	REB Levels Updated. Substation Levels Updated.	GK	TW
C7	13.01.25	Training Yard Levels Updated.	GK	TW
C6	13.12.24	Bunds Updated. Crossing Updated.	GK	TW
P5	15.11.24	Update to REB Service Yard Layout	GK	TW
P4	15.11.24	Update to Car Park Levels	GK	TW
P3	01.11.24	Preliminary Issue	GK	TW
P2	25.10.24	Preliminary Issue	GK	TW
P1	22.07.24	Preliminary Issue	GK	MR

Issues & Revisions

BWB
A CAF GROUP COMPANY

- ☐ Birmingham | 0121 233 3322
- ☐ Leeds | 0113 233 8000
- ■ London | 020 7407 3879
- ☐ Manchester | 0161 233 4260
- ☐ Nottingham | 0115 924 1100

www.bwbconsulting.com

Client

BOWMER AND KIRKLAND LTD.

Project Title

SIEMENS, CHIPPENHAM

Drawing Title

PROPOSED FINISHED LEVELS SHEET 1

Drawn:	G. Karacam	Reviewed:	M.Ross
BWB Ref:	244347	Date:	Jul'24
Scale@A1:	1:500		

Drawing Status

AS-BUILT

Project - Originator - Zone - Level - Type - Role - Number: SMC-BWB-ZZ-XX-D-C-0600 A6

Rev: C17

Authorised FOR HANDOVER

© Copyright BWB Consulting Ltd

J:\2024\244347-Siemens, Chippenham\ProjectDelivery\01-WIP\Drawings\SMC-BWB-ZZ-XX-D-C-0600_Proposed Finished Levels.dwg