


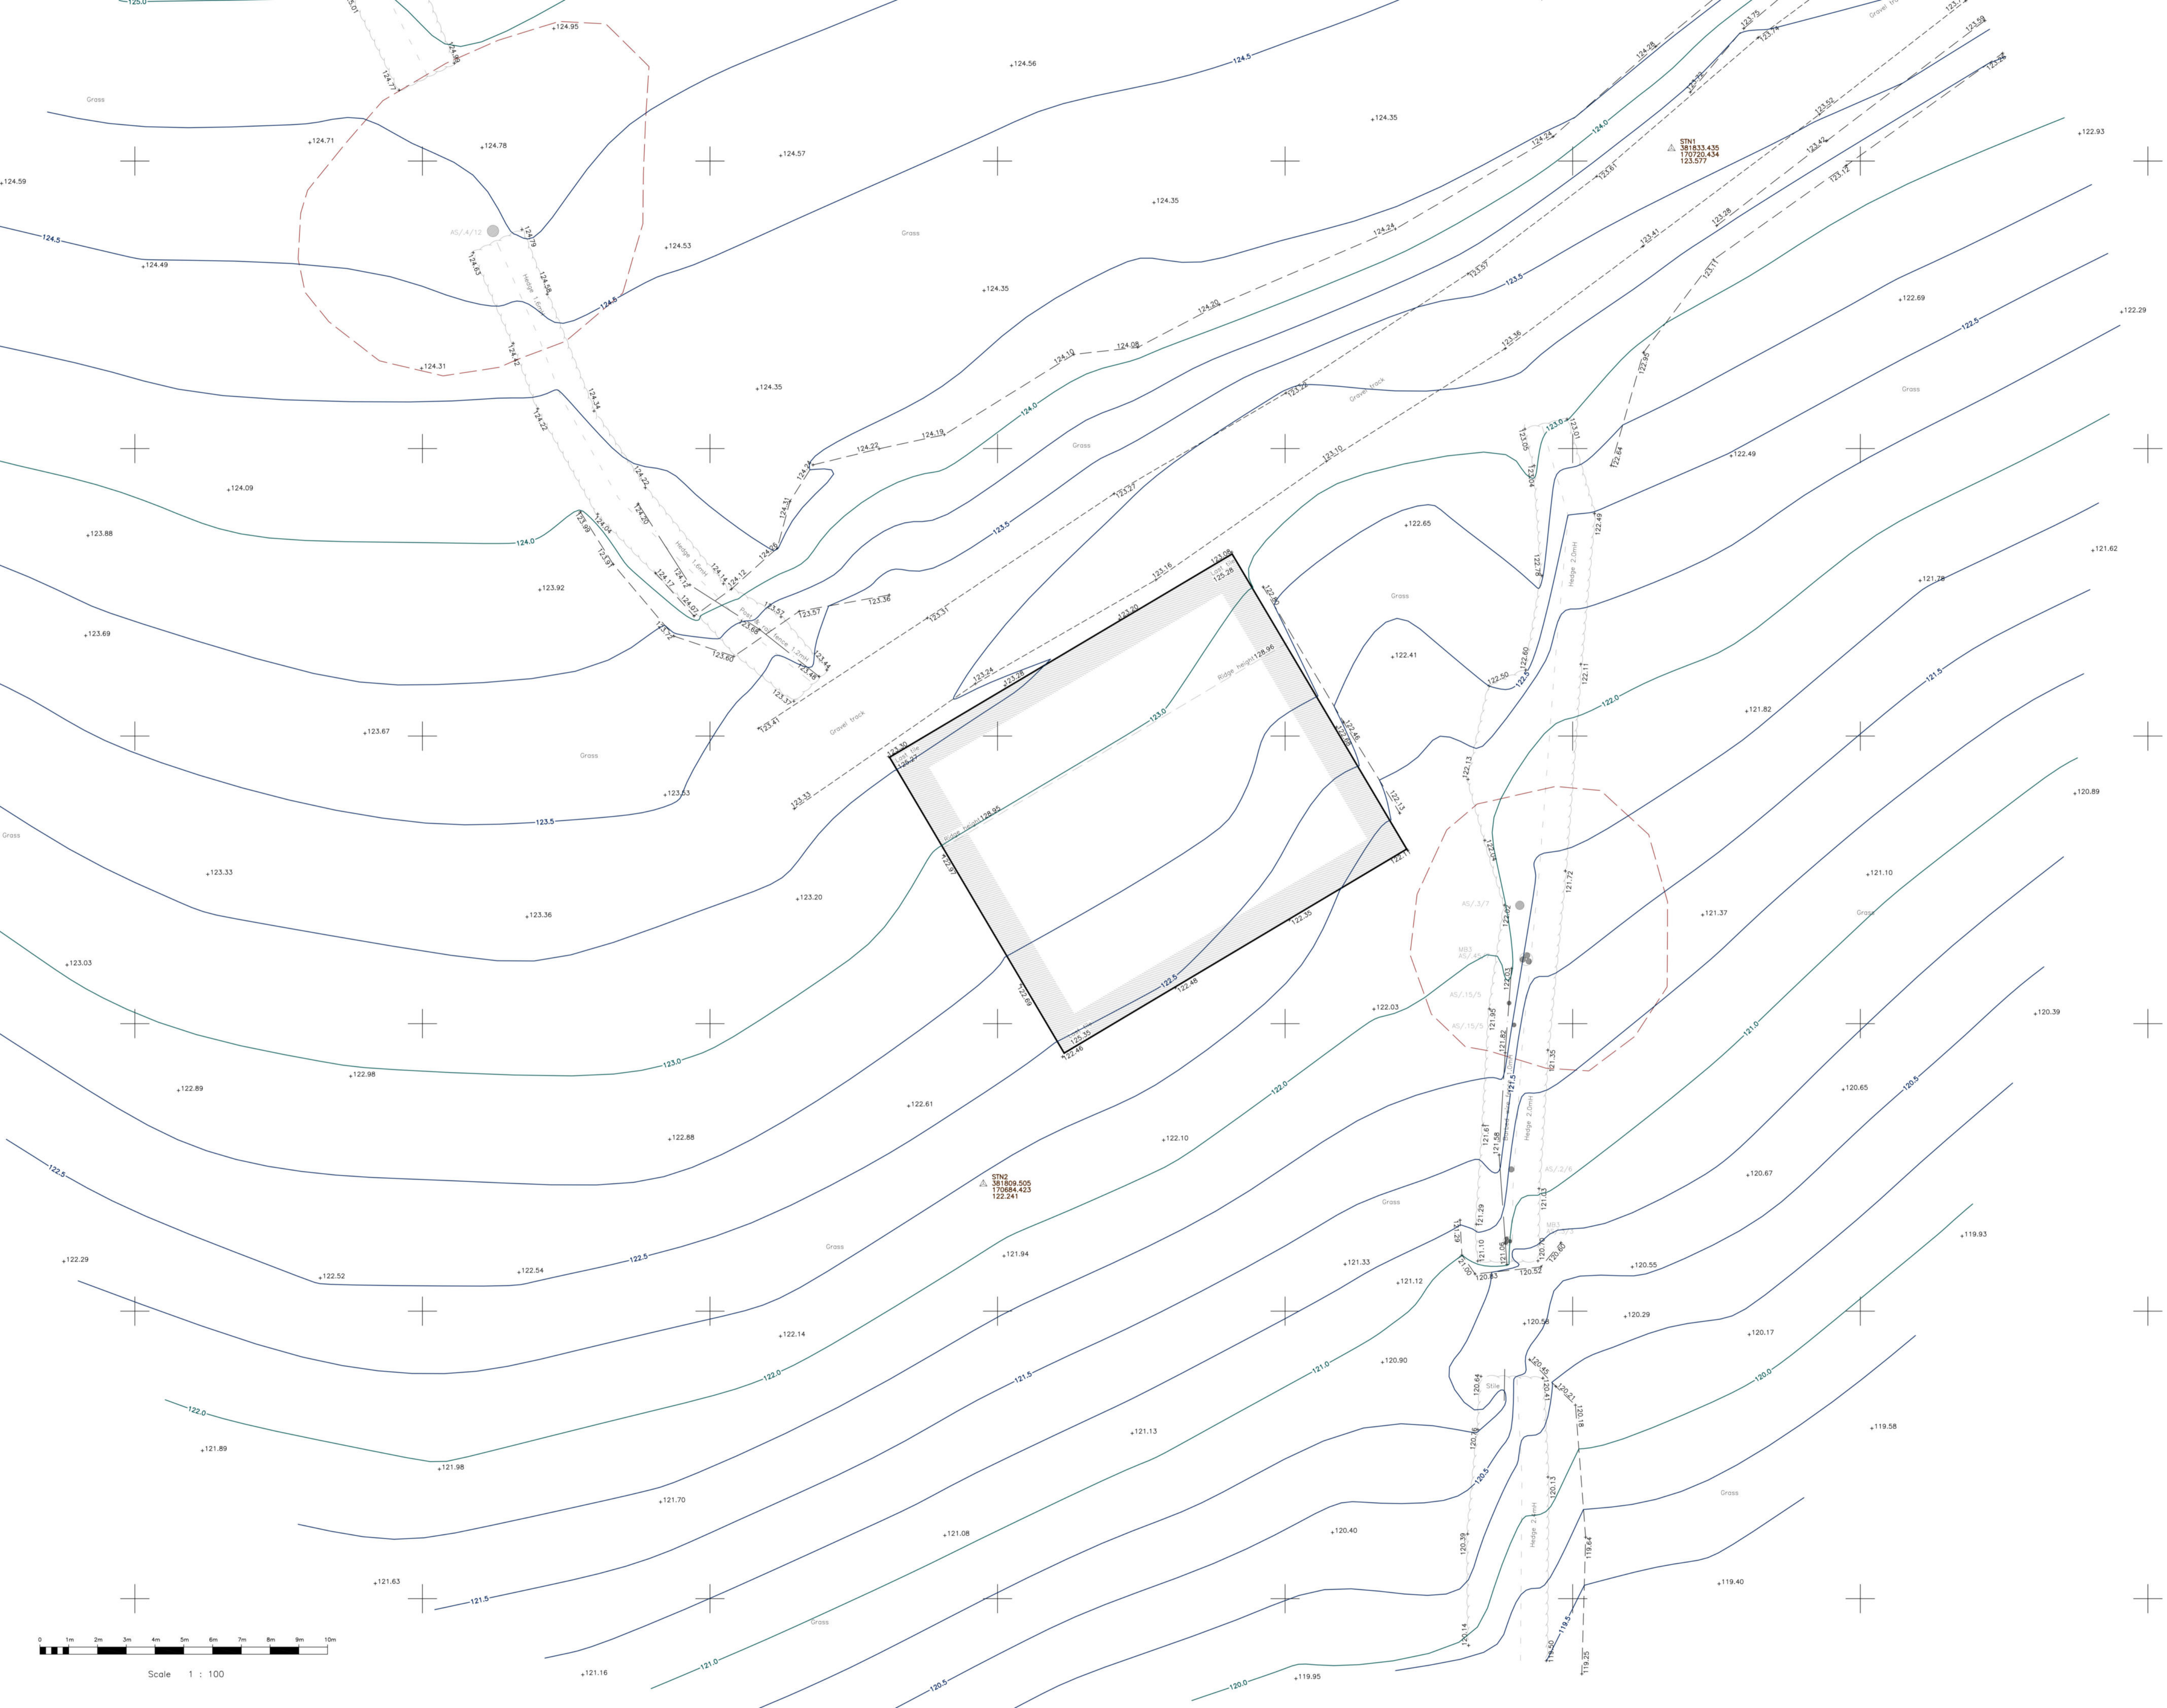

Tree Abbreviations

ASH	Ash	LP	London Plane
BAY	Bay	MAP	Maple
BEE	Beech	OAK	Oak
CB	Copper Beech	POP	Poplar
CED	Cedar	RM	Red Maple
CHE	Cherry	RW	Redwood
CON	Coniferous	SB	Silver Birch
EUC	Eucalyptus	SER	Service Tree
FR	Fruit	SP	Scots Pine
HAW	Hawthorn	SYC	Sycamore
HAZ	Hazel	WAL	Walnut
HC	Horse Chestnut	WILL	Willow
HOL	Holly	WP	Weeping Willow
LAB	Laburnum	YEW	Yew
LAU	Laurel		
LI	Lime		

Trees denoted with "approx" have been surveyed by remote methods and therefore their positions & dimensions cannot be guaranteed.

Tree Dimensions (average) AS - As shown by red line
Spread/Trunk Dia/Height UTS - Unable to survey

Key

AV	Air Valve	LP	Lamp Post
BL	Bollard	M	Meter
BM	Bench Mark	MH	Manhole Cover
BP	Boundary Point	MK	Marker
BT	BT Cover	MS	Milestone
CATV	Cable Television Cover	RG	Ridge Level
cab	Cabinet	RS	Road Sign
cl	Cover Level	rep	Rain Water Pipe
EP	Electric Power Pole	SC	Stop Cock
EV	Eaves Level (u/s fascia)	Str	Strainer
FH	Fire Hydrant	SV	Stop Valve
FL	Floor Level	swp	Spot Vent Pipe
FP	Fence Post	TH	Threshold Level
G	Gully	TL	Traffic Light
GP	Gate Post	TP	Telephone Pole
GV	Gas Valve	UTL	Unable To Lift
IC	Inspection Chamber	VP	Vent Pipe
il	Invert Level	VM	Water Meter
KO	Kerb Outlet	WO	Wash Out

Buildings & Walls Double Gates
Glass Roofed Single Gate

Linetypes

Bank	
Building	
Drop kerb	
Channel	
Electric	
Fence	
Foliage	
FWS (Estimated Size From Surface)	
Grid Cross	
Hedge	
Kerb	
Manhole	
Pipe	
Ridge	
SWS (Estimated Size From Surface)	
Telephone	
Track/Path	
Tree Canopy	
Verge	
Water line	
Wall	

Coordinate System

This survey has been oriented to the O.S. National Grid (OSGB36) via a global position system and the O.S. Active Network (OS Net) OSGB36. True OSGB36 coordinates have been established at STN2 E381809.505 N170684.423 and a further OSGB36 point established to create a true O.S. bearing for angle orientation. All levels are based on O.S.Datum. A scale factor of 1:1 has been applied to the survey and therefore the coordinate system must be considered arbitrary.

DANDOSurveying ltd

Land & Measured Building Surveyors

27-29 New Street
Charfield
South Glos.
GL12 8ES

Tel: 01453 845017
Tel: 01453 845360
www.dandosurveying.co.uk
enquiries@dandosurveying.co.uk

Project Name:
Barn at Tutton Hill Farm
Tutton Hill, Colerne

Drawing Title:
Topographical Survey

Client:
Batterham Smith Architects
Agent:

Date: 29th January 2020	Scale: 1:100 @ A1	
Grid Orientation North GPS	Sheet ID BSA/tuttonTOPO	Rev None
Site Level Datum OS GPS	Surveyed By FT	Drawn By FT